


Scale 1:100

GEO-SURVEYORS
MURPHY SURVEYS LTD
GLOBAL HOUSE,
Unit1, Kilcullen Business Campus
Kilcullen, Co. Kildare
Tel. 045 484040, Fax 045 480004
Email: info@murphysurveys.ie
Web Site: www.murphysurveys.ie

Topographic Surveys - Measured Building Surveys - Hydro-
graphic Surveys - Setting Out Surveys - As-Built Surveys -
Setting Out Surveys - Site Control - Legal Mapping -
Pipeline Surveys - Manhole Surveys - GPS Surveys

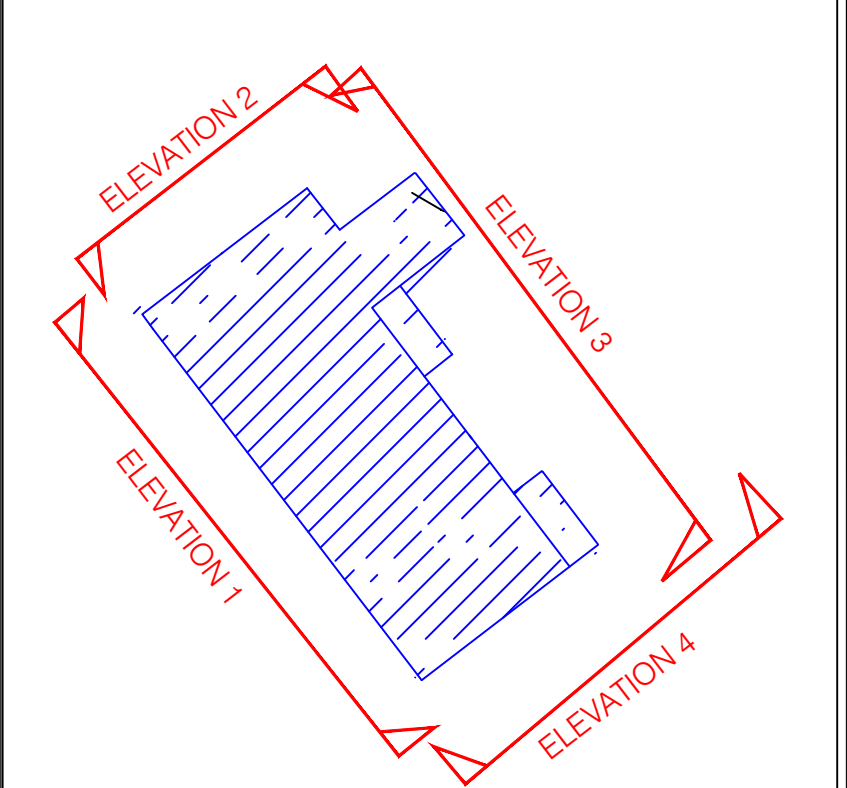


© Copyright MURPHY SURVEYS LTD

Surveyed by:	RO	Date:	03.04.08
Drawn by:	RO	Date:	10.04.08
Checked by:	RO	Date:	10.04.08

Revisions		
No.	Date	Description
1	10.04.08	First Drawing

Note :
ALL LEVELS ARE RELATIVE TO OSI MALIN HEAD DATUM



SURVEYS LTD

Client : Murphy Surveys Limited

Scale : as shown **Date :** 10.04.08

Project : Ballymany Newbridge

Description : Elevations Survey

Drawing Number : 08250_E_1_2_3_4_C1