


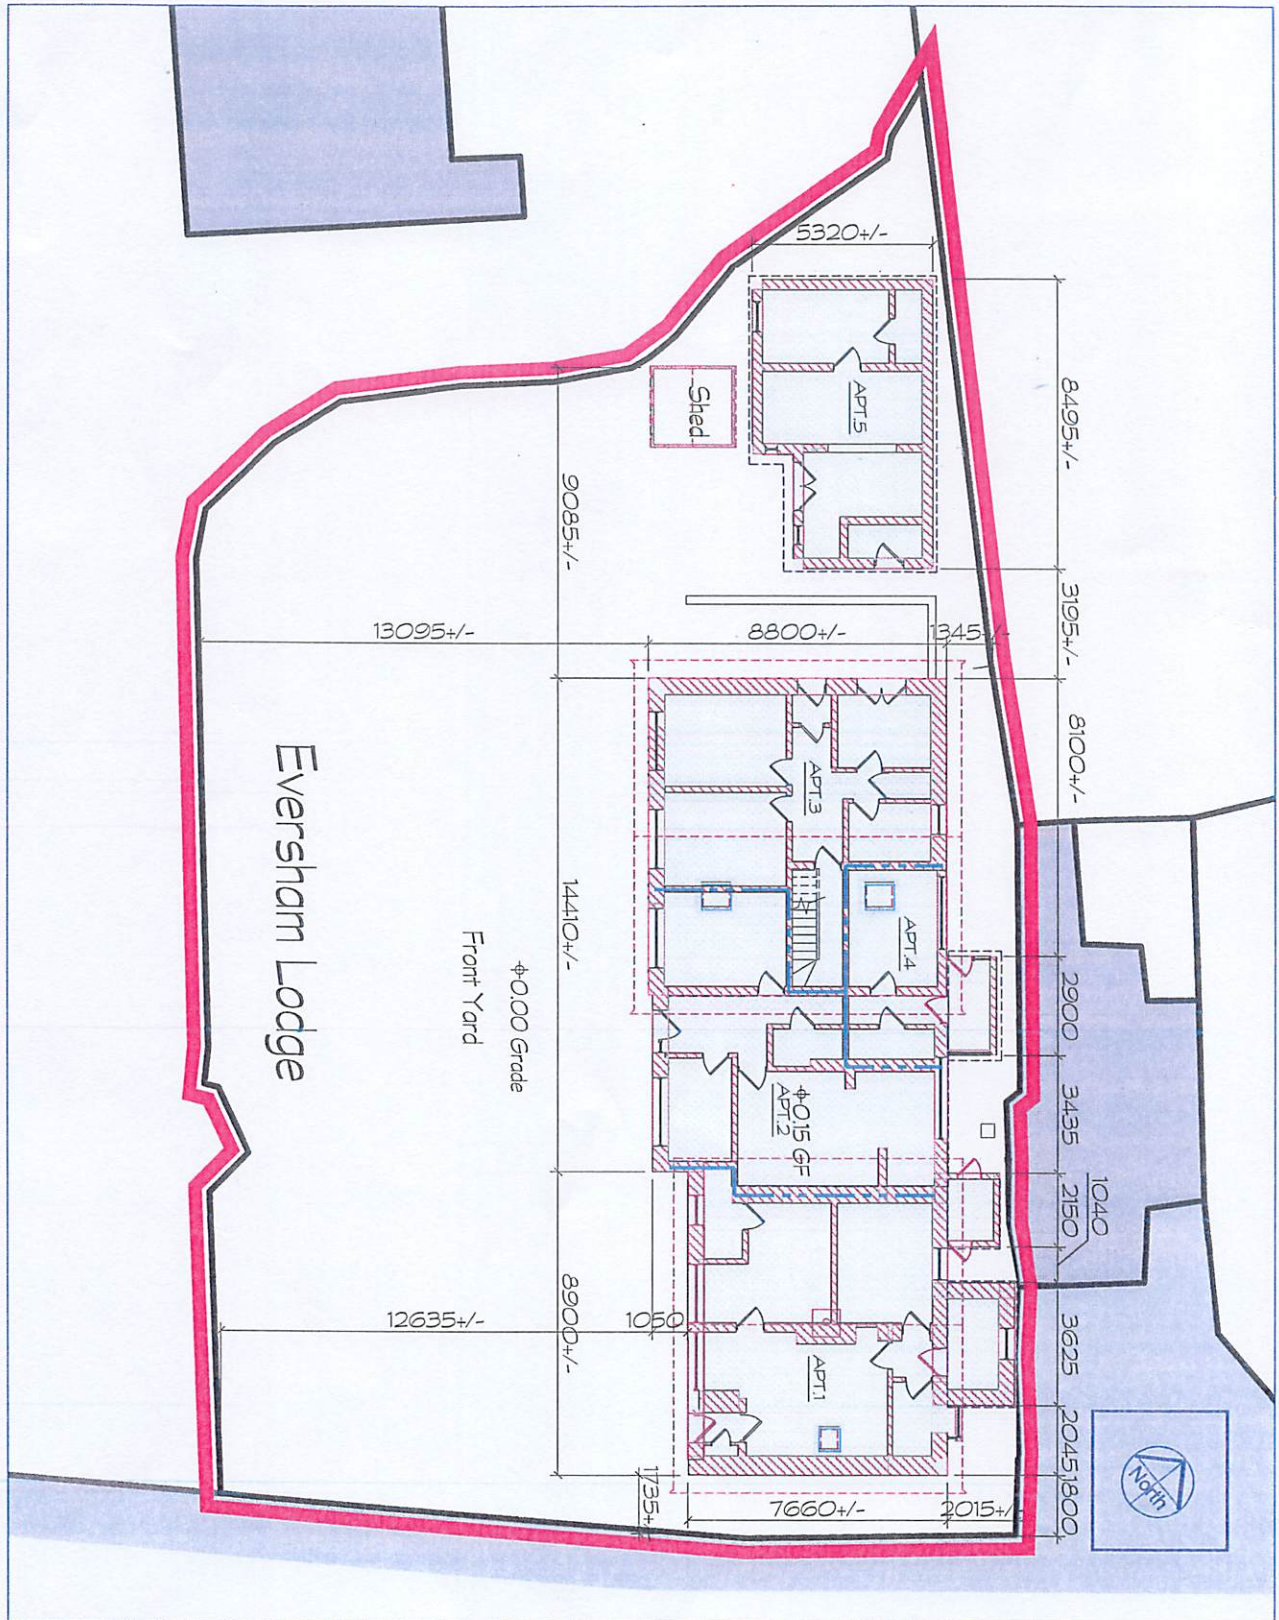

As-Built Layouts
Not Intended for Construction



www.mciarch.com

MCI ARCHITECTURE

41 Mount Anville Park
Dublin 14, Ireland

Tel: (+353-1) 278-1754
email: admin@mciarch.com

Client
Sean McBennett
Eversham Lodge
Newtownpark Ave, Blackrock, Co. Dublin

Project Name
Eversham Lodge

Project No.
24-601

Dwg Title

AS-BUILT SITE PLAN

Note:

1. Use figure dimensions only.
2. Dimensions on building represent Structural Op's only.
3. No part of this document may be transmitted or reproduced in any form without the approval of MCONNELL INTERNATIONAL, except as agreed for use on the project for which the document was originally issued.

SCALE As Indicated

DATE May, 2025

DRAWN BY RMc

Dwg No.

AB-101

Revision