



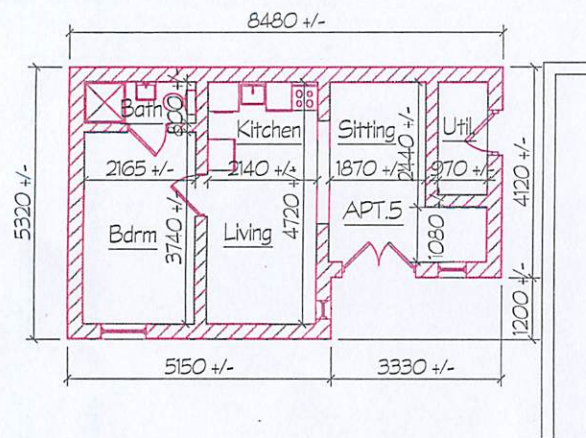


3 EXISTING DETACHED APT.5 GROUND FLOOR LAYOUT
1:100

LIVING AREA	
INDIVIDUAL APART. AREAS	
APT. 1 Ground Floor	55.9 m ²
APT. 2 Ground Floor	46.8 m ²
APT. 3 Ground Floor	46.3 m ²
APT. 3 First Floor	32.5 m ²
APT. 4 Ground Floor	18.3 m ²
APT. 5 Ground Floor	30.2 m ²
Total Residential Living Area (Incl. Interior Separation Walls)	207.3 m ²

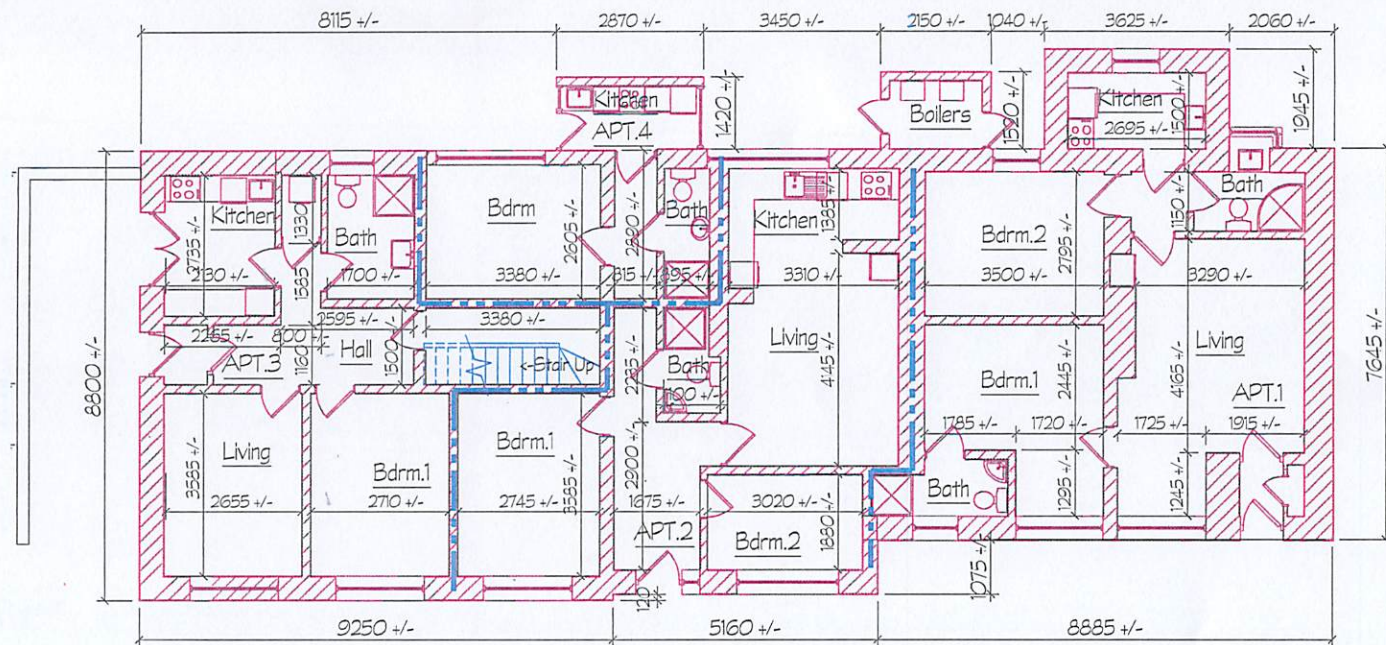

1 EXISTING APTS 1-4 GROUND FLOOR LAYOUT
1:100

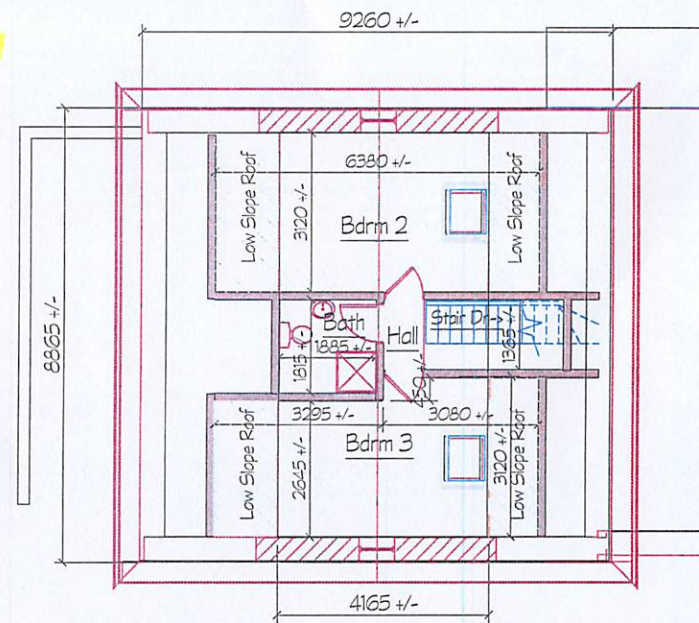

2 EXISTING APT.3 FIRST FLOOR LAYOUT
1:100

As-Built Layouts
Not Intended for Construction

Note:		SCALE	As Indicated
1. Use for reference only.		DATE	May, 2025
2. Dimensions on building represent structural.		DRAWN BY	RMG
3. No part of this document may be transmitted or reproduced in any form without the written consent of the architect.		Dwg No.	AB-102
except as signed for use on the project for which the document was originally issued.		Reason	
AS-BUILT FLOOR LAYOUTS			
Sean McBennett Eversham Lodge Newtownpark Ave, Blackrock, Co. Dublin		Project No.	24-601
Client		Project Name	Eversham Lodge
www.mcarch.com		MCI ARCHITECTURE	
41 Mount Anville Park Dublin 14, Ireland		Tel: (+353-1) 278-1754 email: r.mcginn@mcarch.com	