


Planning Pack Map

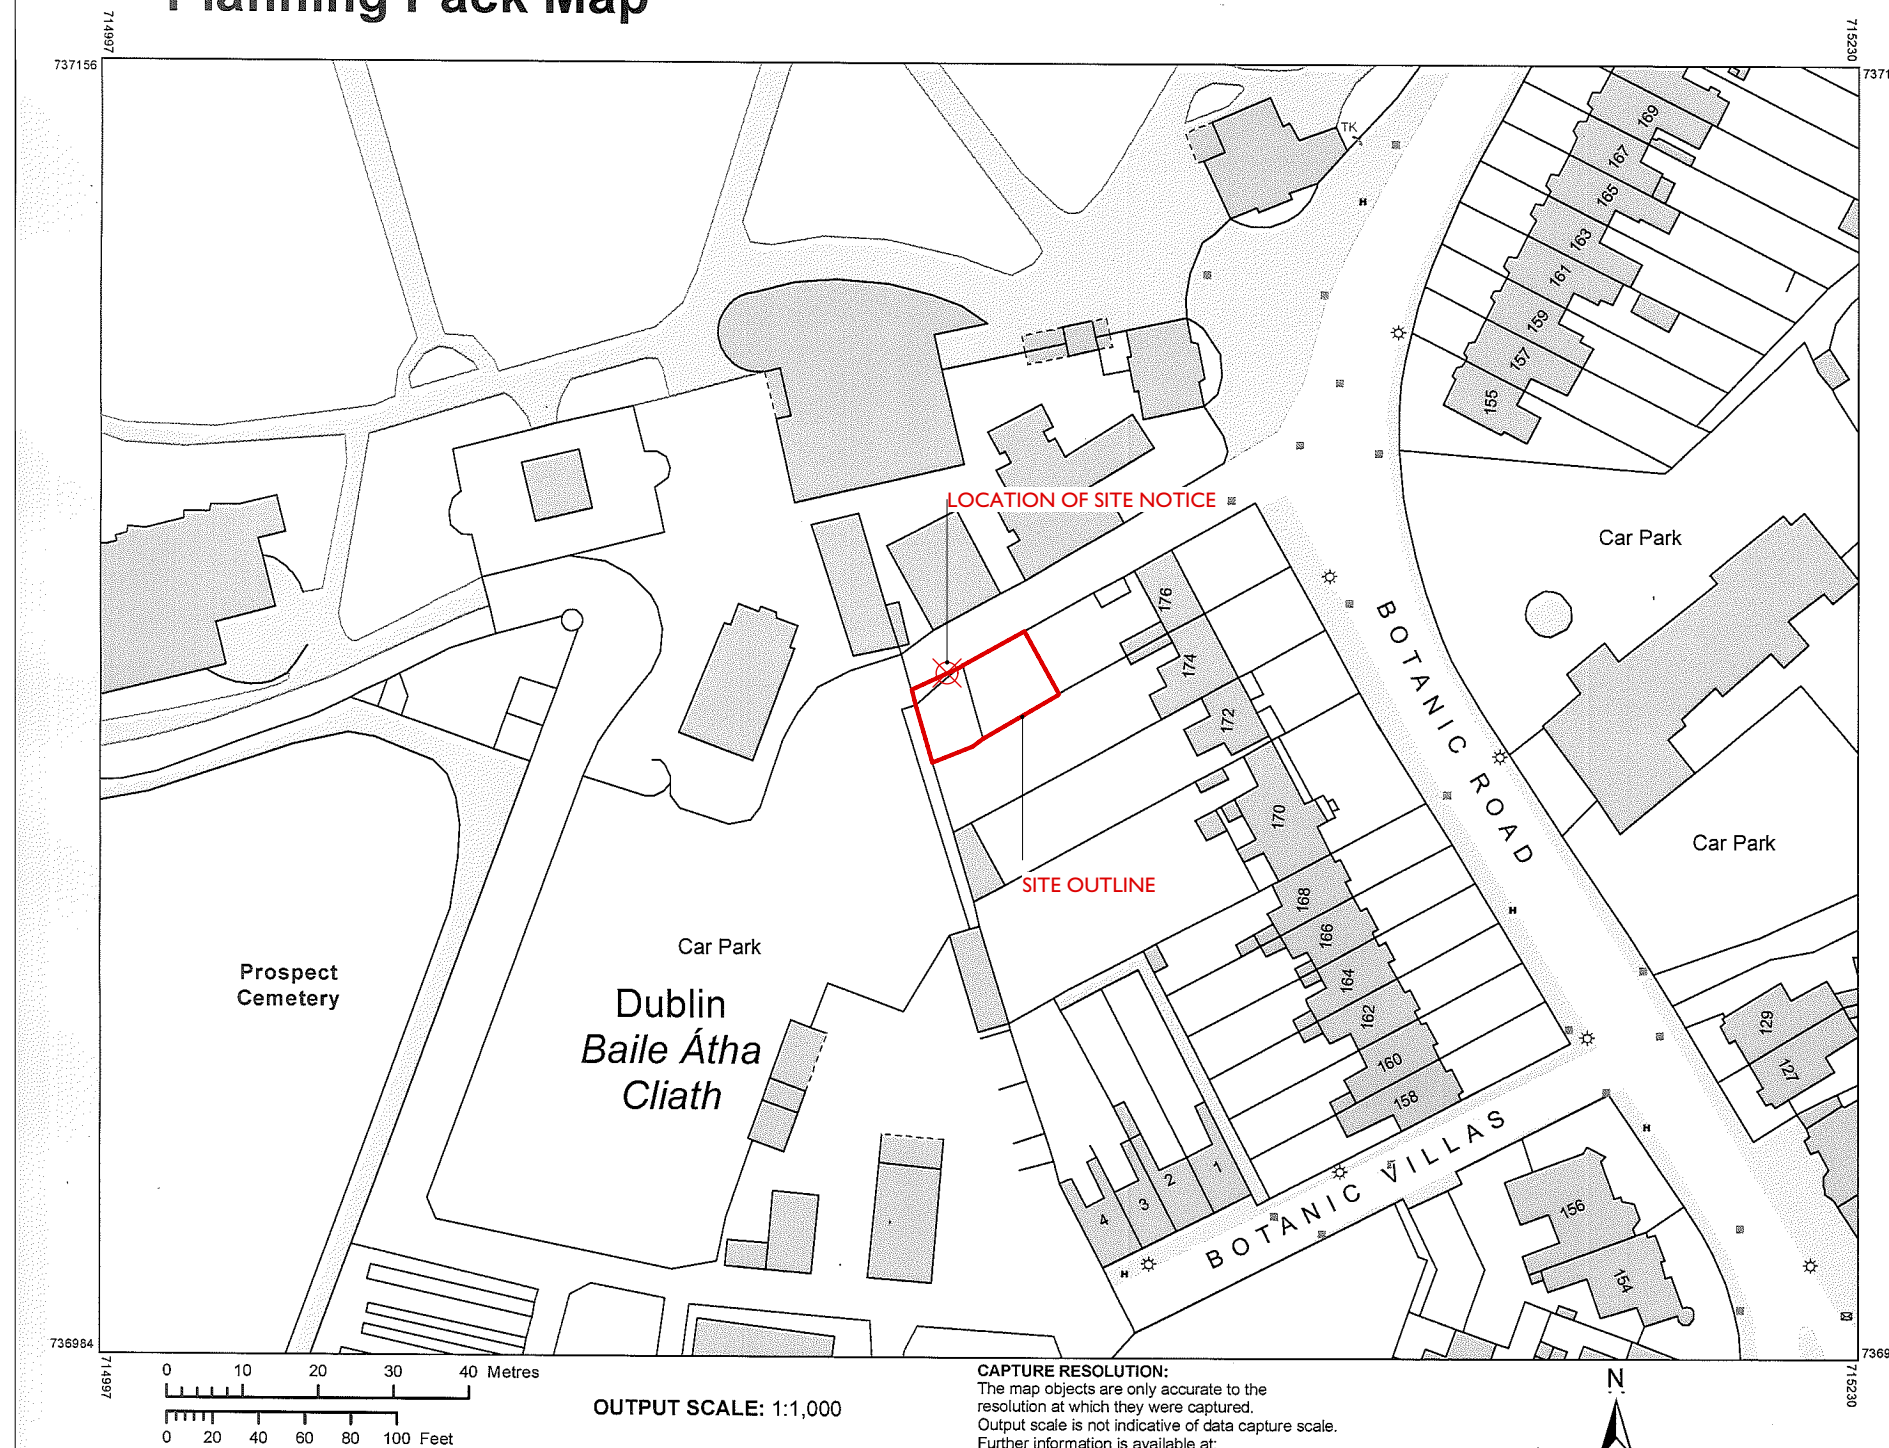

CENTRE COORDINATES:
ITM 715114,737070

PUBLISHED: 28/02/2019
ORDER NO.: 50049535_1

MAP SERIES: 1:1,000
MAP SHEETS: 3197-09
1:1,000 3197-10

COMPILED AND PUBLISHED BY:
Ordnance Survey Ireland,
Phoenix Park,
Dublin 8,
Ireland.

Unauthorised reproduction
infringes Ordnance Survey Ireland
and Government of Ireland
copyright.

All rights reserved.
No part of this publication may
be copied, reproduced
or transmitted in any form
or by any means without the prior
written permission of
the copyright owners.

The representation on this map
of a road, track or footpath
is not evidence of the existence
of a right of way.

Ordnance Survey maps
never show legal property
boundaries, nor do they
show ownership of
physical features.

© Suirbhéireacht Ordanáis Éireann,
2019
© Ordnance Survey Ireland, 2019
www.osi.ie/copyright

LEGEND:
<http://www.osi.ie>;
search 'Large Scale Legend'

I SITE LOCATION
BHD-001 1:1000

GENERAL NOTES AND COMMENTS

- Use figured dimensions only. Do not scale off hard copy or .dwg files.
- Check all dimensions on site.
- Notify the architect of any discrepancies immediately.
- Read all drawings in conjunction with the relevant architect's specifications and other design drawings and / or details for further information.

DISCLAIMER

This document is confidential and has been issued in accordance with our conditions of appointment solely for the use of the named client for the purposes of describing a design intent for a specific project and / or for the client entering into a building contract. All third parties should note that the document has been prepared for a specific client brief, statutory regime and geographic location. Accordingly, the advice contained herein are **not** intended for any third parties and may have been amplified or amended by unidentified matters elsewhere described. Third parties should rely on their own current, independent, experienced professional advice. The document expressly does **not** provide any warranty whatsoever including as to the as-built conditions which could materially vary.

mcgarry ní éanaigh architects expressly **disclaims** any and all liabilities to any and all third parties arising from this document. If you have received this document in error, please notify McGarry Ní Éanaigh architects immediately.

COPYRIGHT MCGARRY NÍ ÉANAIGH ARCHITECTS TEO

REV:	DATE:	STATUS:	DRAWN:	APPROVED:	ISSUED:	TEXT:
A:	11.12.2018	FI	CF	MMCG	CF	PRELIMINARY DRAWING FOR INFO
B:	01.03.2019	FI	CF	MMCG	CF	
C:	07.03.2019	FP	CF	MMCG	CF	PLANNING
FI:INFO FA:APPROVAL FP:PLANNING FT:TENDER FC:CONSTRUCTION						


TITLE: SITE LOCATION

PROJECT: BOTANIC HOUSE DUBLIN
CLIENT: HUGH + SASKIA MCDONNELL

JOB NUMBER: 1609
SCALE: 1:1000

DRAWING NUMBER:
BHD - 001
C
PLANNING

McGARRY NÍ ÉANAIGH ARCHITECTS
23 Mountjoy Square
Dublin 1 Ireland
+353 1 888 0840
info@mcgnie.ie www.mcgnie.ie

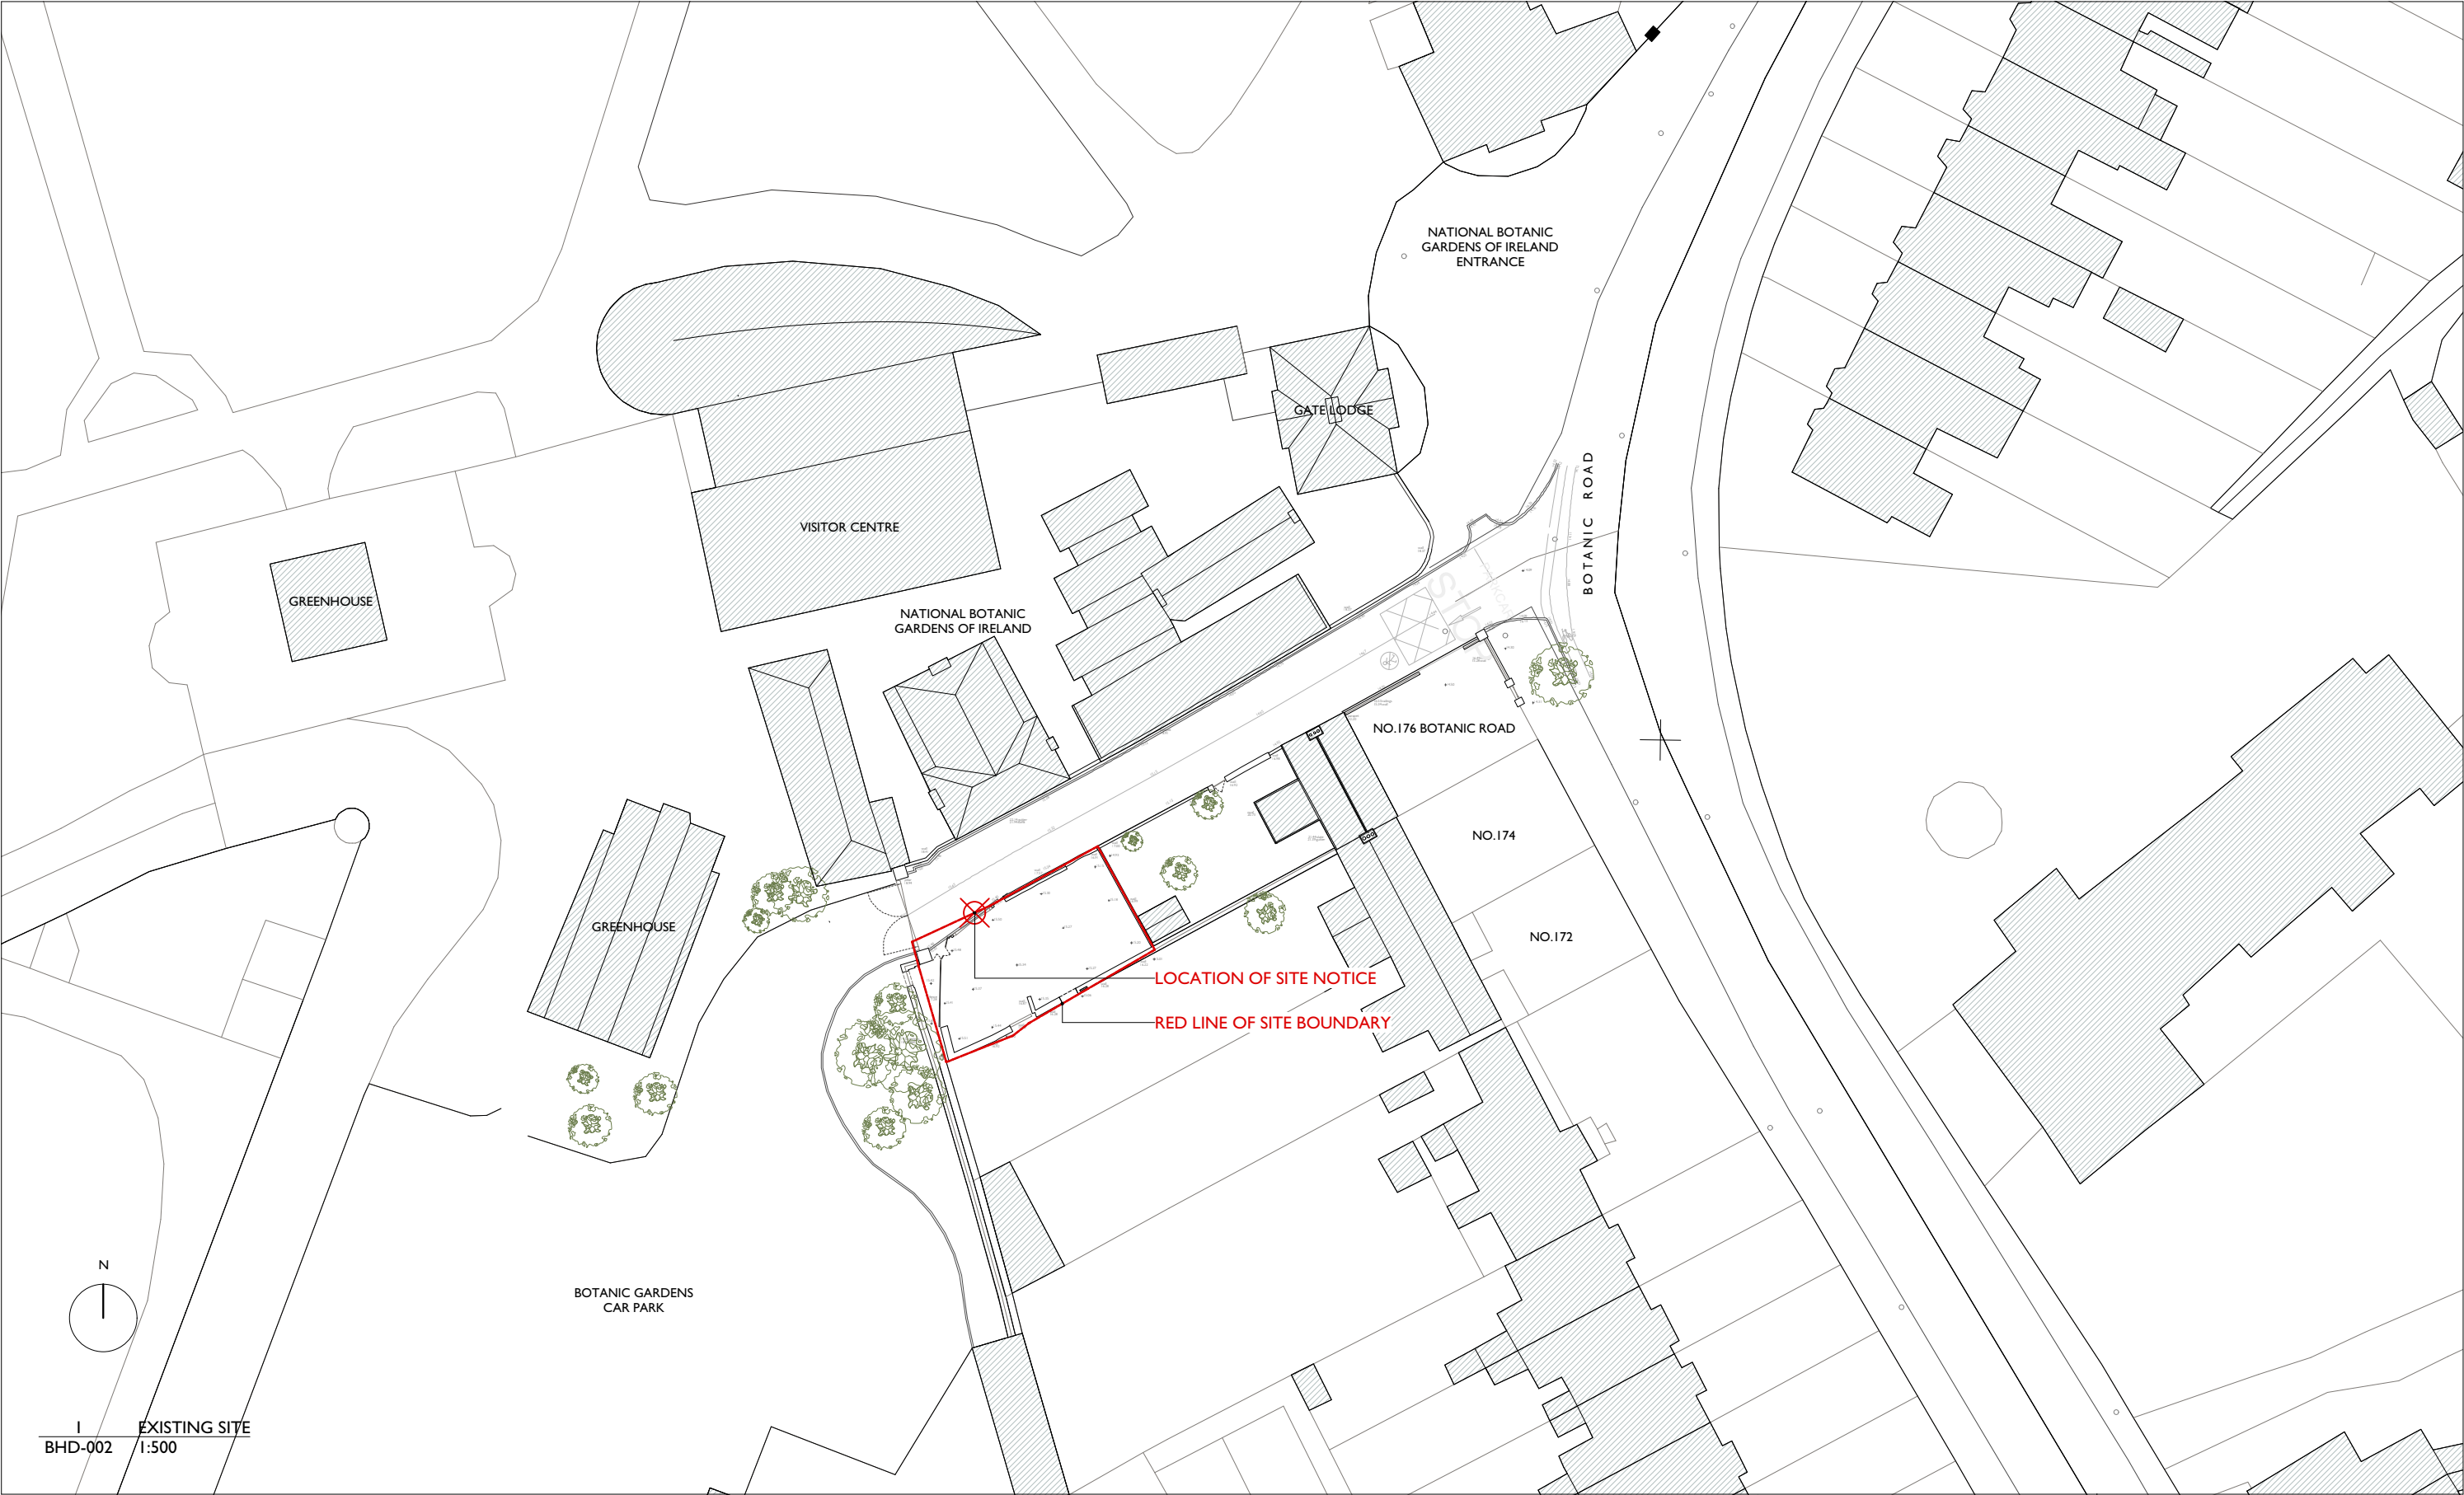

GENERAL NOTES AND COMMENTS

- Use figured dimensions only. Do not scale off hard copy or .dwg files.
- Check all dimensions on site.
- Notify the architect of any discrepancies immediately.
- Read all drawings in conjunction with the relevant architect's specifications and other design drawings and / or details for further information.

COPYRIGHT McGARRY NÍ ÉANAIGH ARCHITECTS TEO

DISCLAIMER

This document is confidential and has been issued in accordance with our conditions of appointment solely for the use of the named client for the purposes of describing a design intent for a specific project and / or for the client entering into a building contract. All third parties should note that the document has been prepared for a specific client brief, statutory regime and geographic location. Accordingly, the advice contained herein are **not** intended for any third parties and may have been amplified or amended by unidentified matters elsewhere described. Third parties should rely on their own current, independent, experienced professional advice. The document expressly does **not** provide any warranty whatsoever including as to the as-built conditions which could materially vary. mcgarry ní éanaigh architects expressly **disclaims** any and all liabilities to any and all third parties arising from this document. if you have received this document in error, please notify McGarry Ní Éanaigh architects immediately.

REV:	DATE:	STATUS:	DRAWN:	APPROVED:	ISSUED:	TEXT:
A:	11.12.2018	FI	CF	MMCG	MMCG	FOR INFO
B:	01.03.2019	FI	CF	MMCG	CF	FOR INFO
C:	07.03.2019	FP	CF	MMCG	CF	PLANNING
FI:INFO FA:APPROVAL FP:PLANNING FT:TENDER FC:CONSTRUCTION						

TITLE: SITE LAYOUT


PROJECT: BOTANIC HOUSE DUBLIN
CLIENT: HUGH + SASKIA MCDONNELL

JOB NUMBER: 1609
SCALE: 1:500

DRAWING NUMBER:
BHD - 002

C
PLANNING

McGARRY NÍ ÉANAIGH
ARCHITECTS
23 Mountjoy Square
Dublin 1 Ireland
+353 1 888 0840
info@mcgnie.ie www.mcgnie.ie

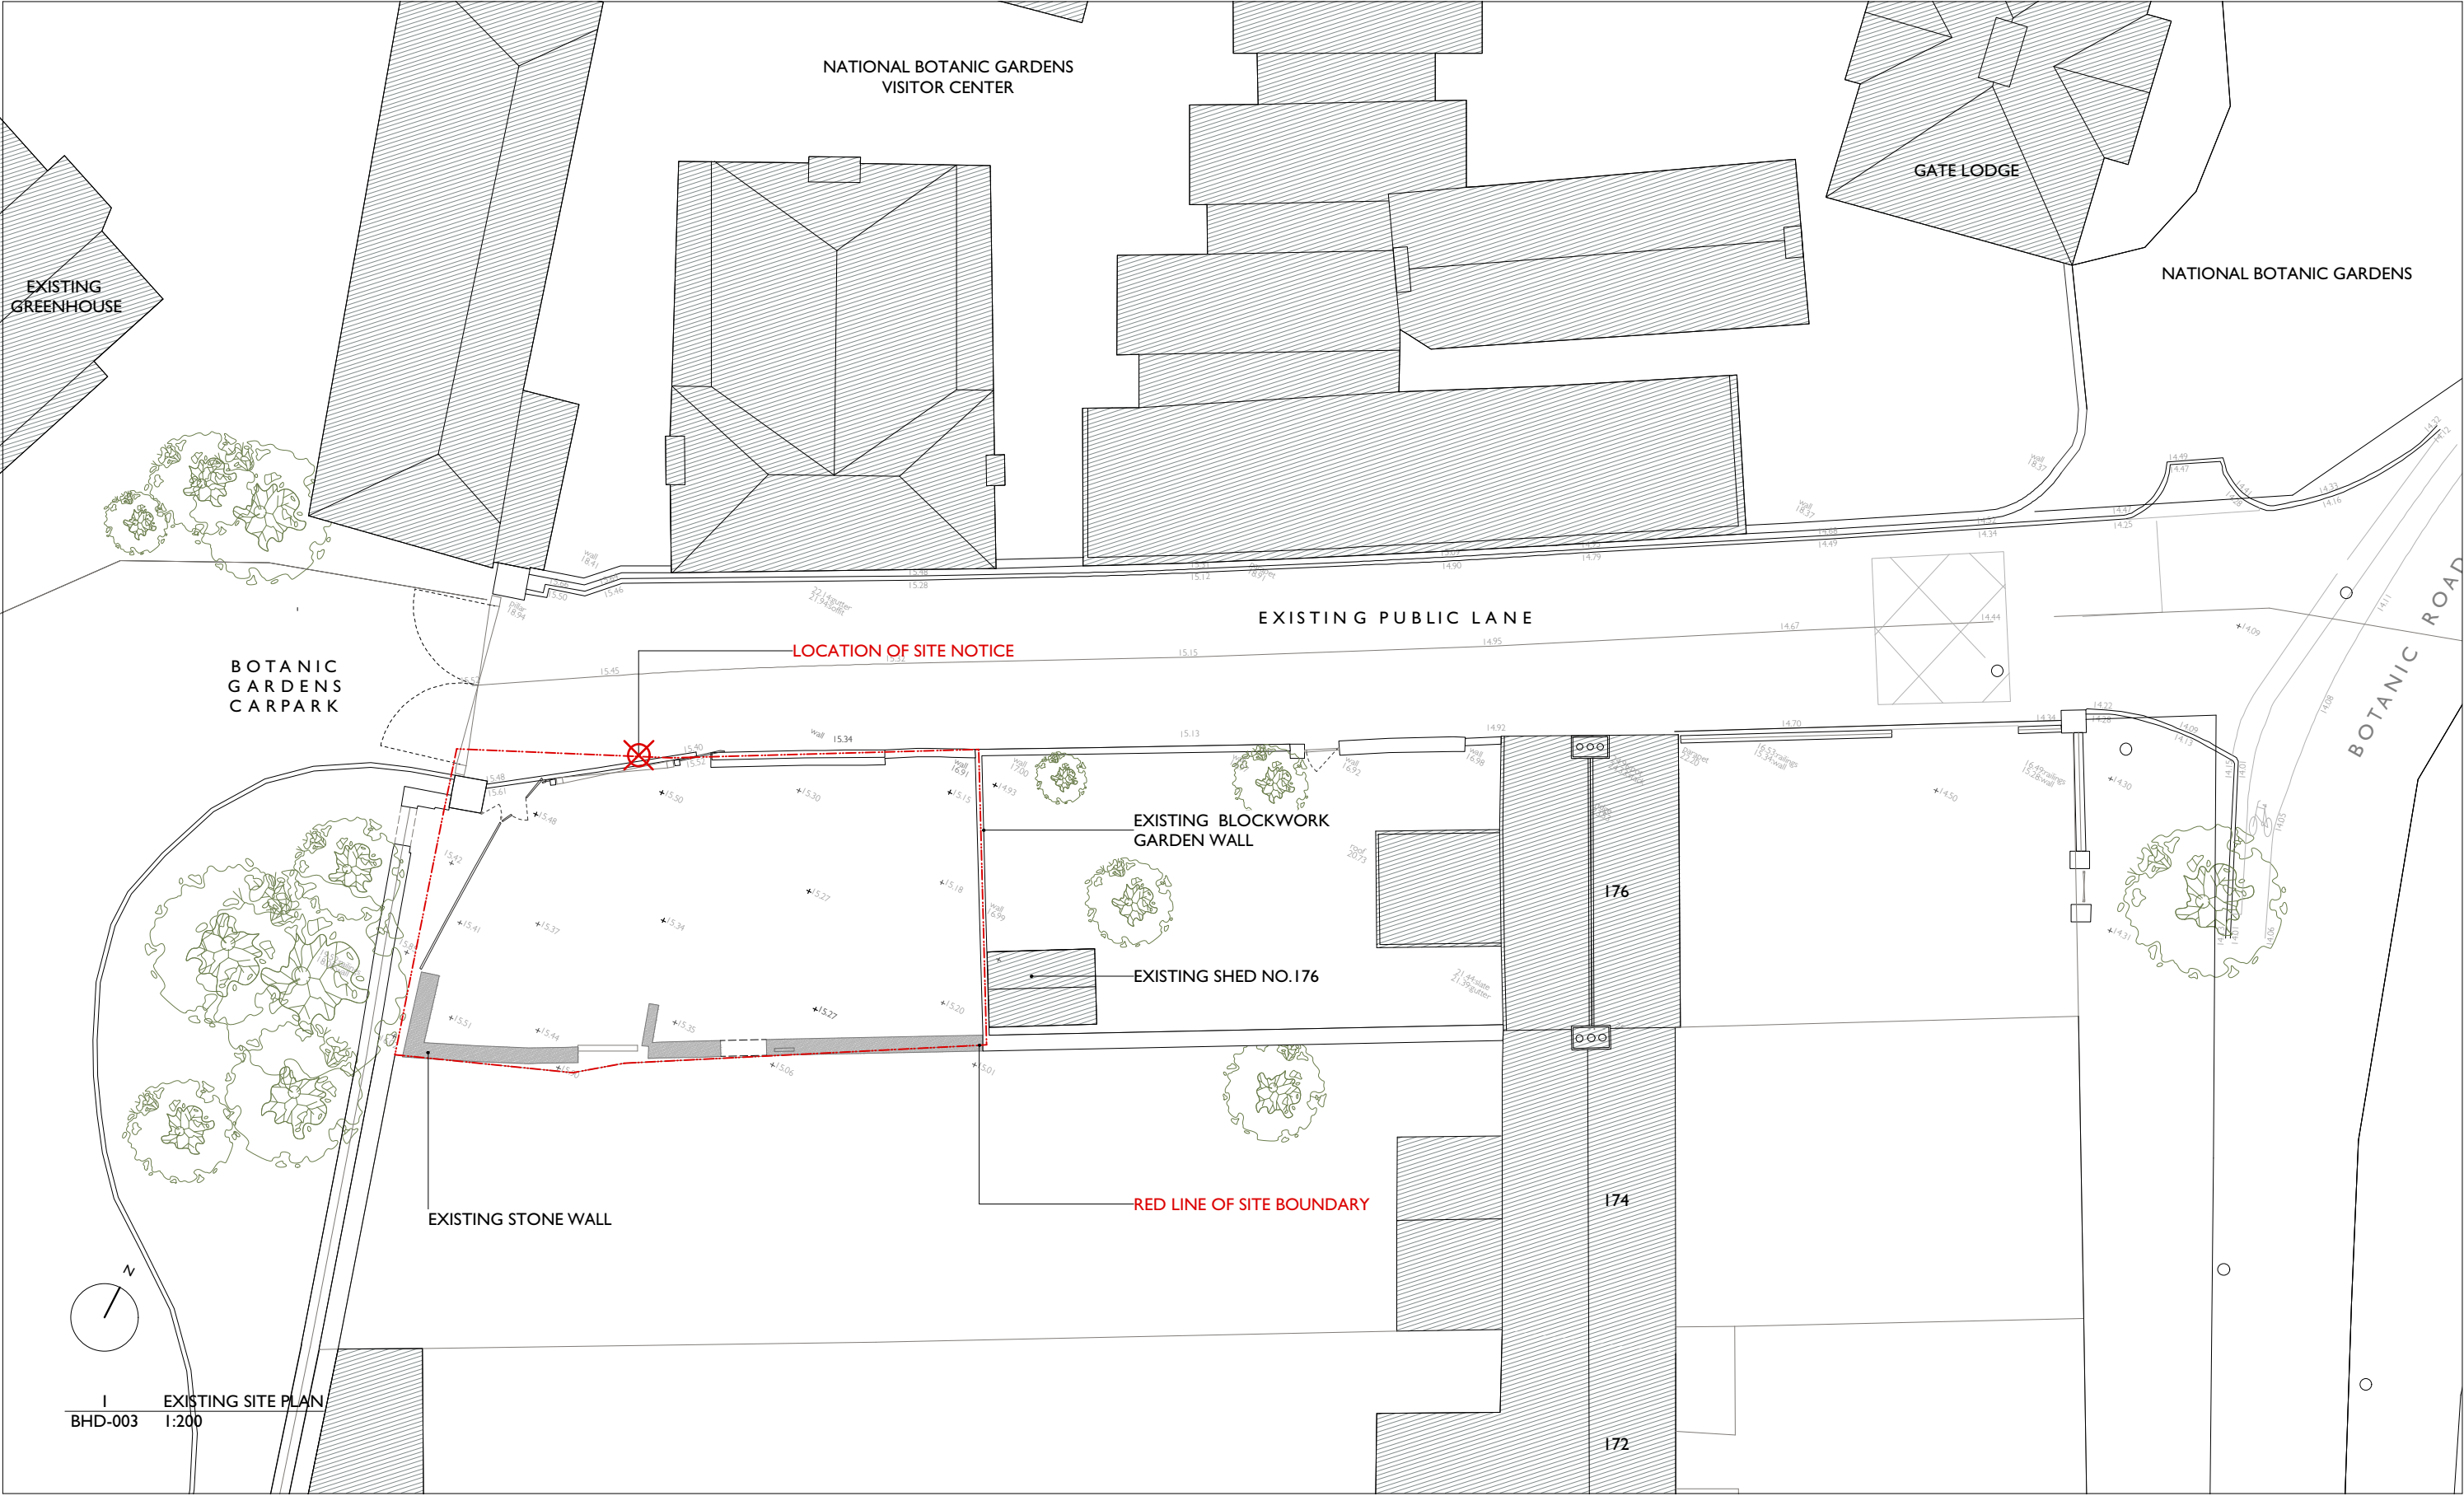

GENERAL NOTES AND COMMENTS

- Use figured dimensions only. Do not scale off hard copy or .dwg files.
- Check all dimensions on site.
- Notify the architect of any discrepancies immediately.
- Read all drawings in conjunction with the relevant architect's specifications and other design drawings and / or details for further information.

DISCLAIMER

This document is confidential and has been issued in accordance with our conditions of appointment solely for the use of the named client for the purposes of describing a design intent for a specific project and / or for the client entering into a building contract. All third parties should note that the document has been prepared for a specific client, brief, statutory regime and geographic location. Accordingly, the advice contained herein is **not** intended for any third parties and may have been amplified or amended by unidentified matters elsewhere described. Third parties should rely on their own current, independent, experienced professional advice. The document expressly does **not** provide any warranty whatsoever including as to the as-built conditions which could materially vary. mcgarry ní éanaigh architects expressly **disclaims** any and all liabilities to any and all third parties arising from this document. If you have received this document in error, please notify McGarry Ní Éanaigh architects immediately.

COPYRIGHT McGARRY NÍ ÉANAIGH ARCHITECTS TEO

REV:	DATE:	STATUS:	DRAWN:	APPROVED:	ISSUED:	TEXT:
B:	01.01.2019	FI	CF	MMCG	CF	FOR INFO
C:	07.03.2019	FP	CF	MMCG	CF	PLANNING
D:	07.03.2019	FP	CF	MMCG	CF	PLANNING
FI:INFO FA:APPROVAL FP:PLANNING FT:TENDER FC:CONSTRUCTION						

TITLE: EXISTING SITE PLAN


PROJECT: BOTANIC HOUSE DUBLIN
CLIENT: HUGH + SASKIA MCDONNELL

JOB NUMBER: 1609
SCALE: 1:200

DRAWING NUMBER:
BHD - 003

B
PLANNING

McGARRY NÍ ÉANAIGH
ARCHITECTS
23 Mountjoy Square
Dublin 1 Ireland
+353 1 888 0840
info@mcgnie.ie www.mcgnie.ie

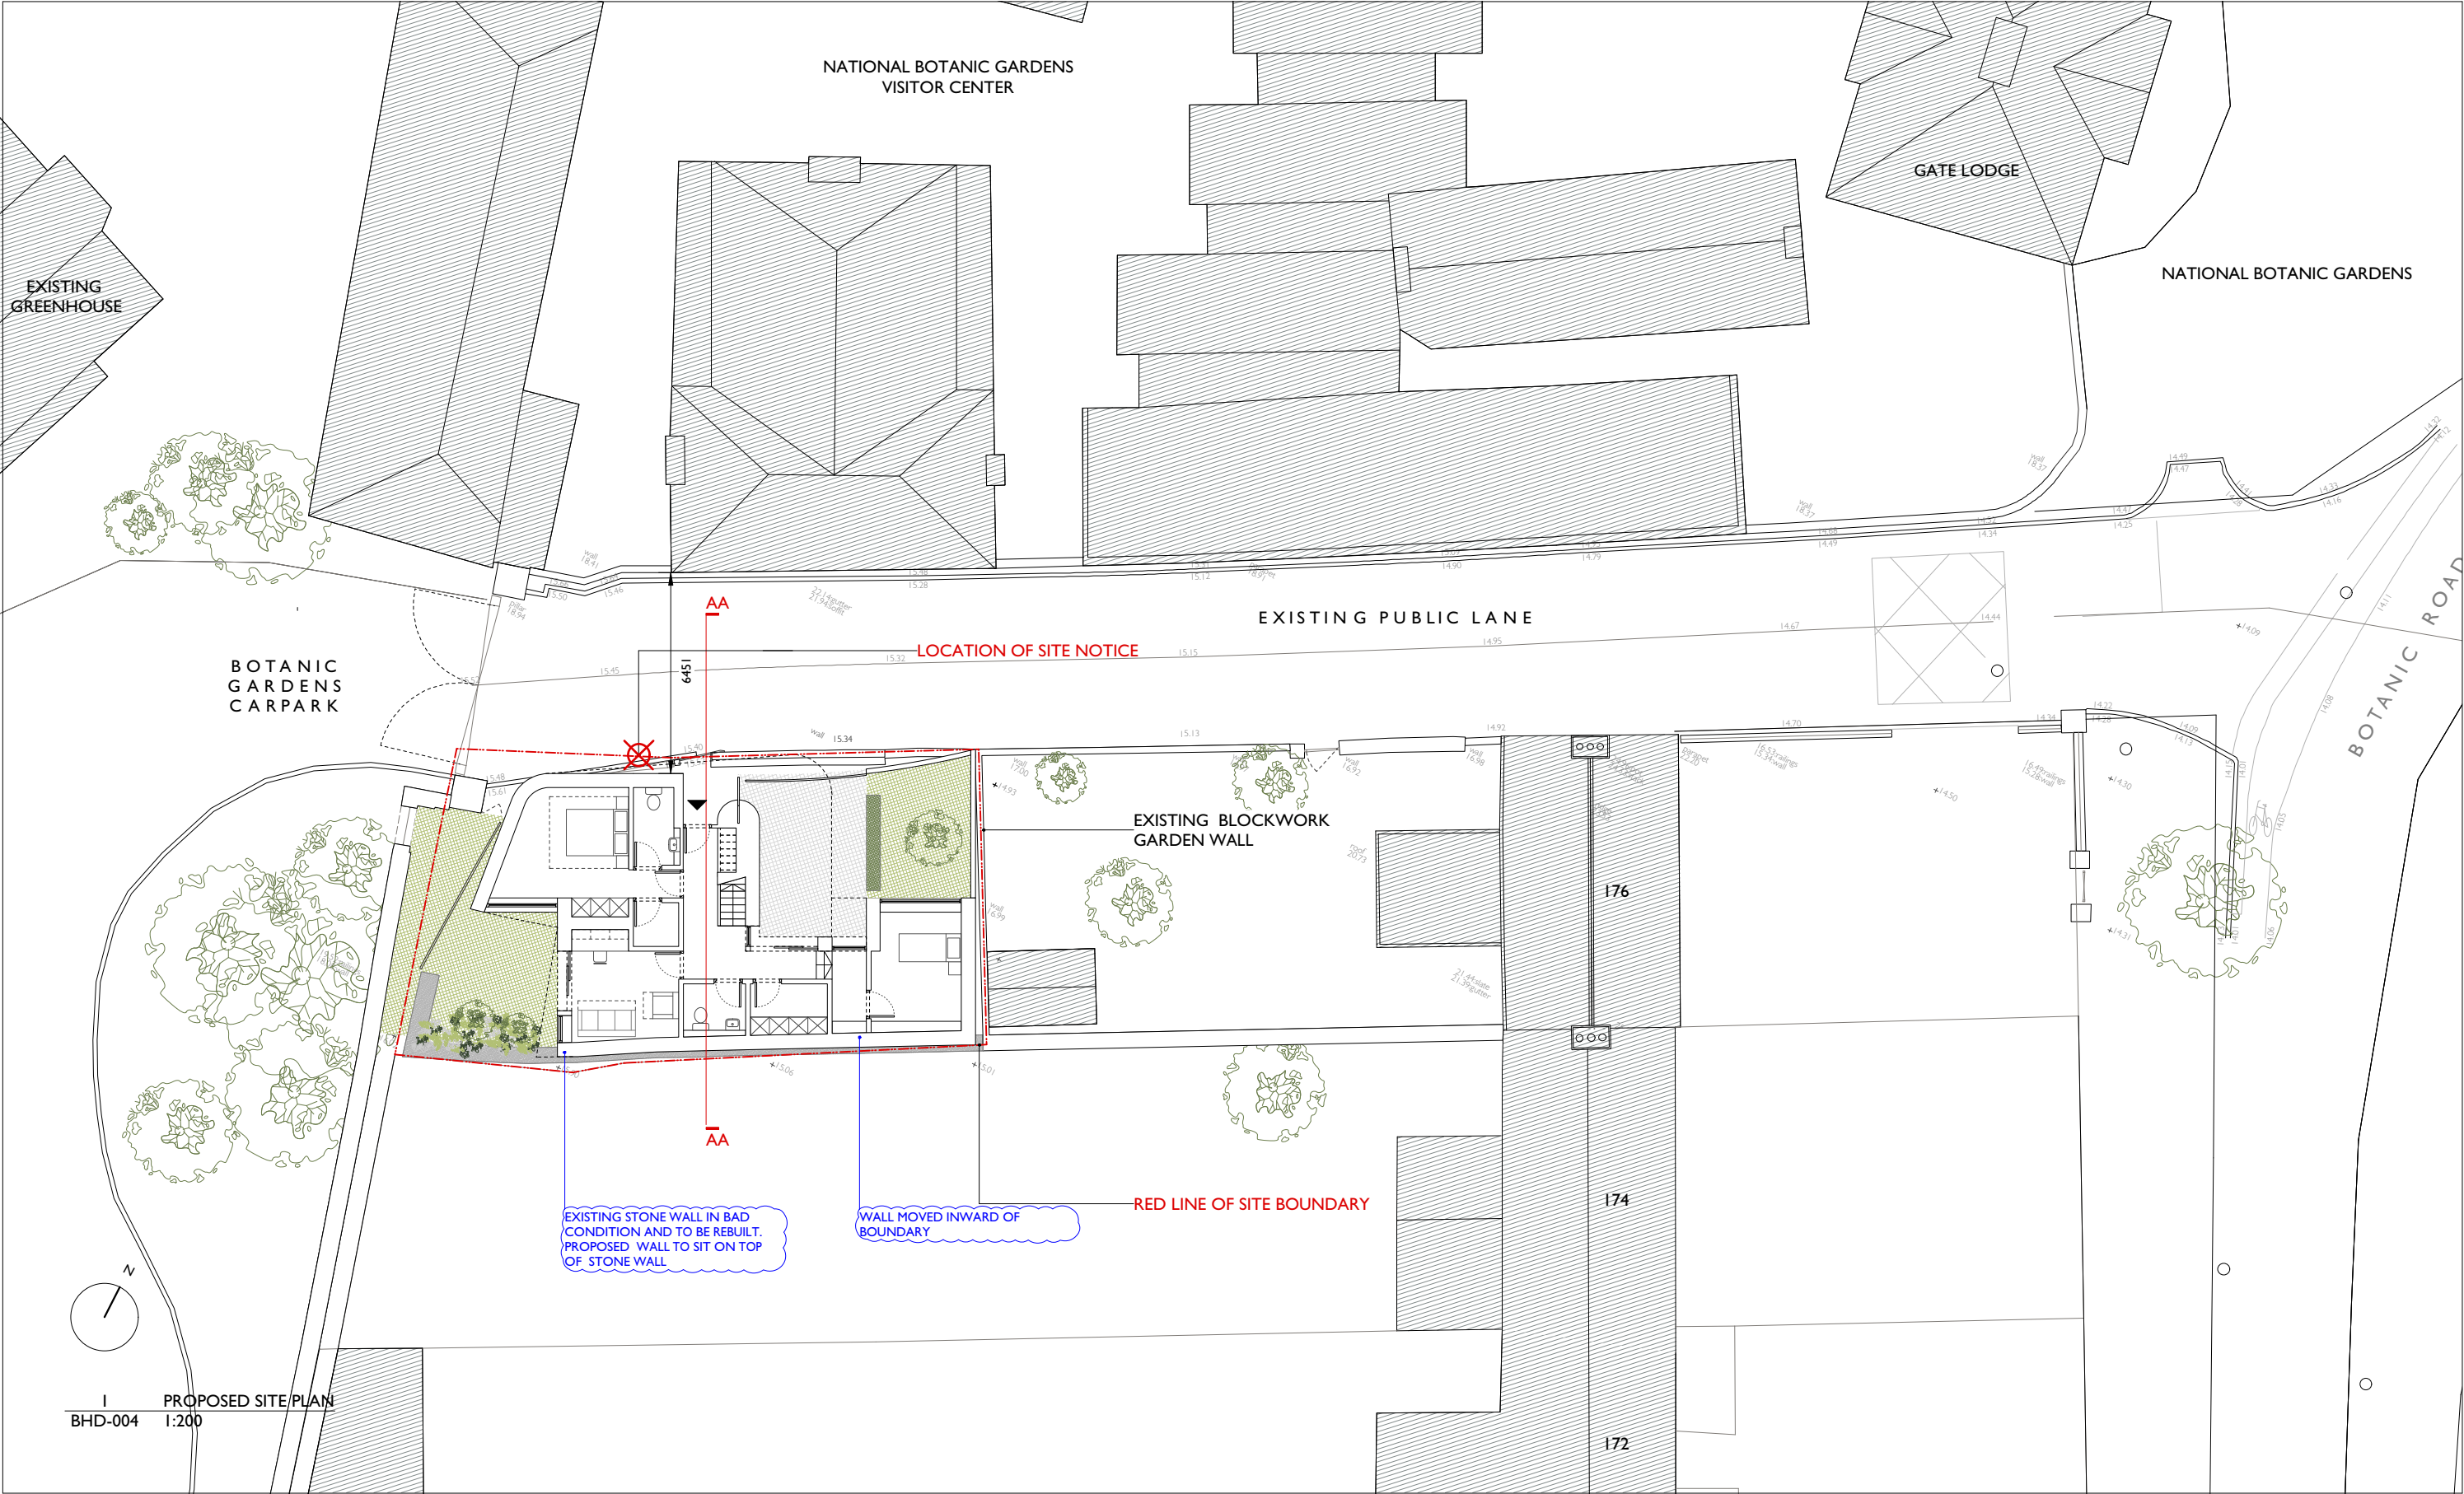

GENERAL NOTES AND COMMENTS

- Use figured dimensions only. Do not scale off hard copy or .dwg files.
- Check all dimensions on site.
- Notify the architect of any discrepancies immediately.
- Read all drawings in conjunction with the relevant architect's specifications and other design drawings and / or details for further information.

DISCLAIMER

This document is confidential and has been issued in accordance with our conditions of appointment solely for the use of the named client for the purposes of describing a design intent for a specific project and / or for the client entering into a building contract. All third parties should note that the document has been prepared for a specific client, brief, statutory regime and geographic location. Accordingly, the advice contained herein are **not** intended for any third parties and may have been amplified or amended by unidentified matters elsewhere described. Third parties should rely on their own current, independent, experienced professional advice. The document expressly does **not** provide any warranty whatsoever including as to the as-built conditions which could materially vary. mcgarry ní éanaigh architects expressly **disclaims** any and all liabilities to any and all third parties arising from this document. If you have received this document in error, please notify McGarry Ní Éanaigh architects immediately.

COPYRIGHT MCGARRY NÍ ÉANAIGH ARCHITECTS TEO

REV:	DATE:	STATUS:	DRAWN:	APPROVED:	ISSUED:	TEXT:
B:	11.12.2018	FI	CF	MMCG	CF	FOR INFO
C:	07.03.2019	FP	CF	MMCG	CF	FOR PLANNING
D:	10.11.2019	FP	CF	MMDD	CF	RFI
FI:INFO FA:APPROVAL FP:PLANNING FT:TENDER FC:CONSTRUCTION						


TITLE: PROPOSED SITE PLAN

PROJECT: BOTANIC HOUSE DUBLIN
CLIENT: HUGH + SASKIA MCDONNELL

JOB NUMBER: 1609
SCALE: 1:200

DRAWING NUMBER:
BHD - 004
C
PLANNING

McGARRY NÍ ÉANAIGH ARCHITECTS
23 Mountjoy Square
Dublin 1 Ireland
+353 1 888 0840
info@mcgnie.ie www.mcgnie.ie

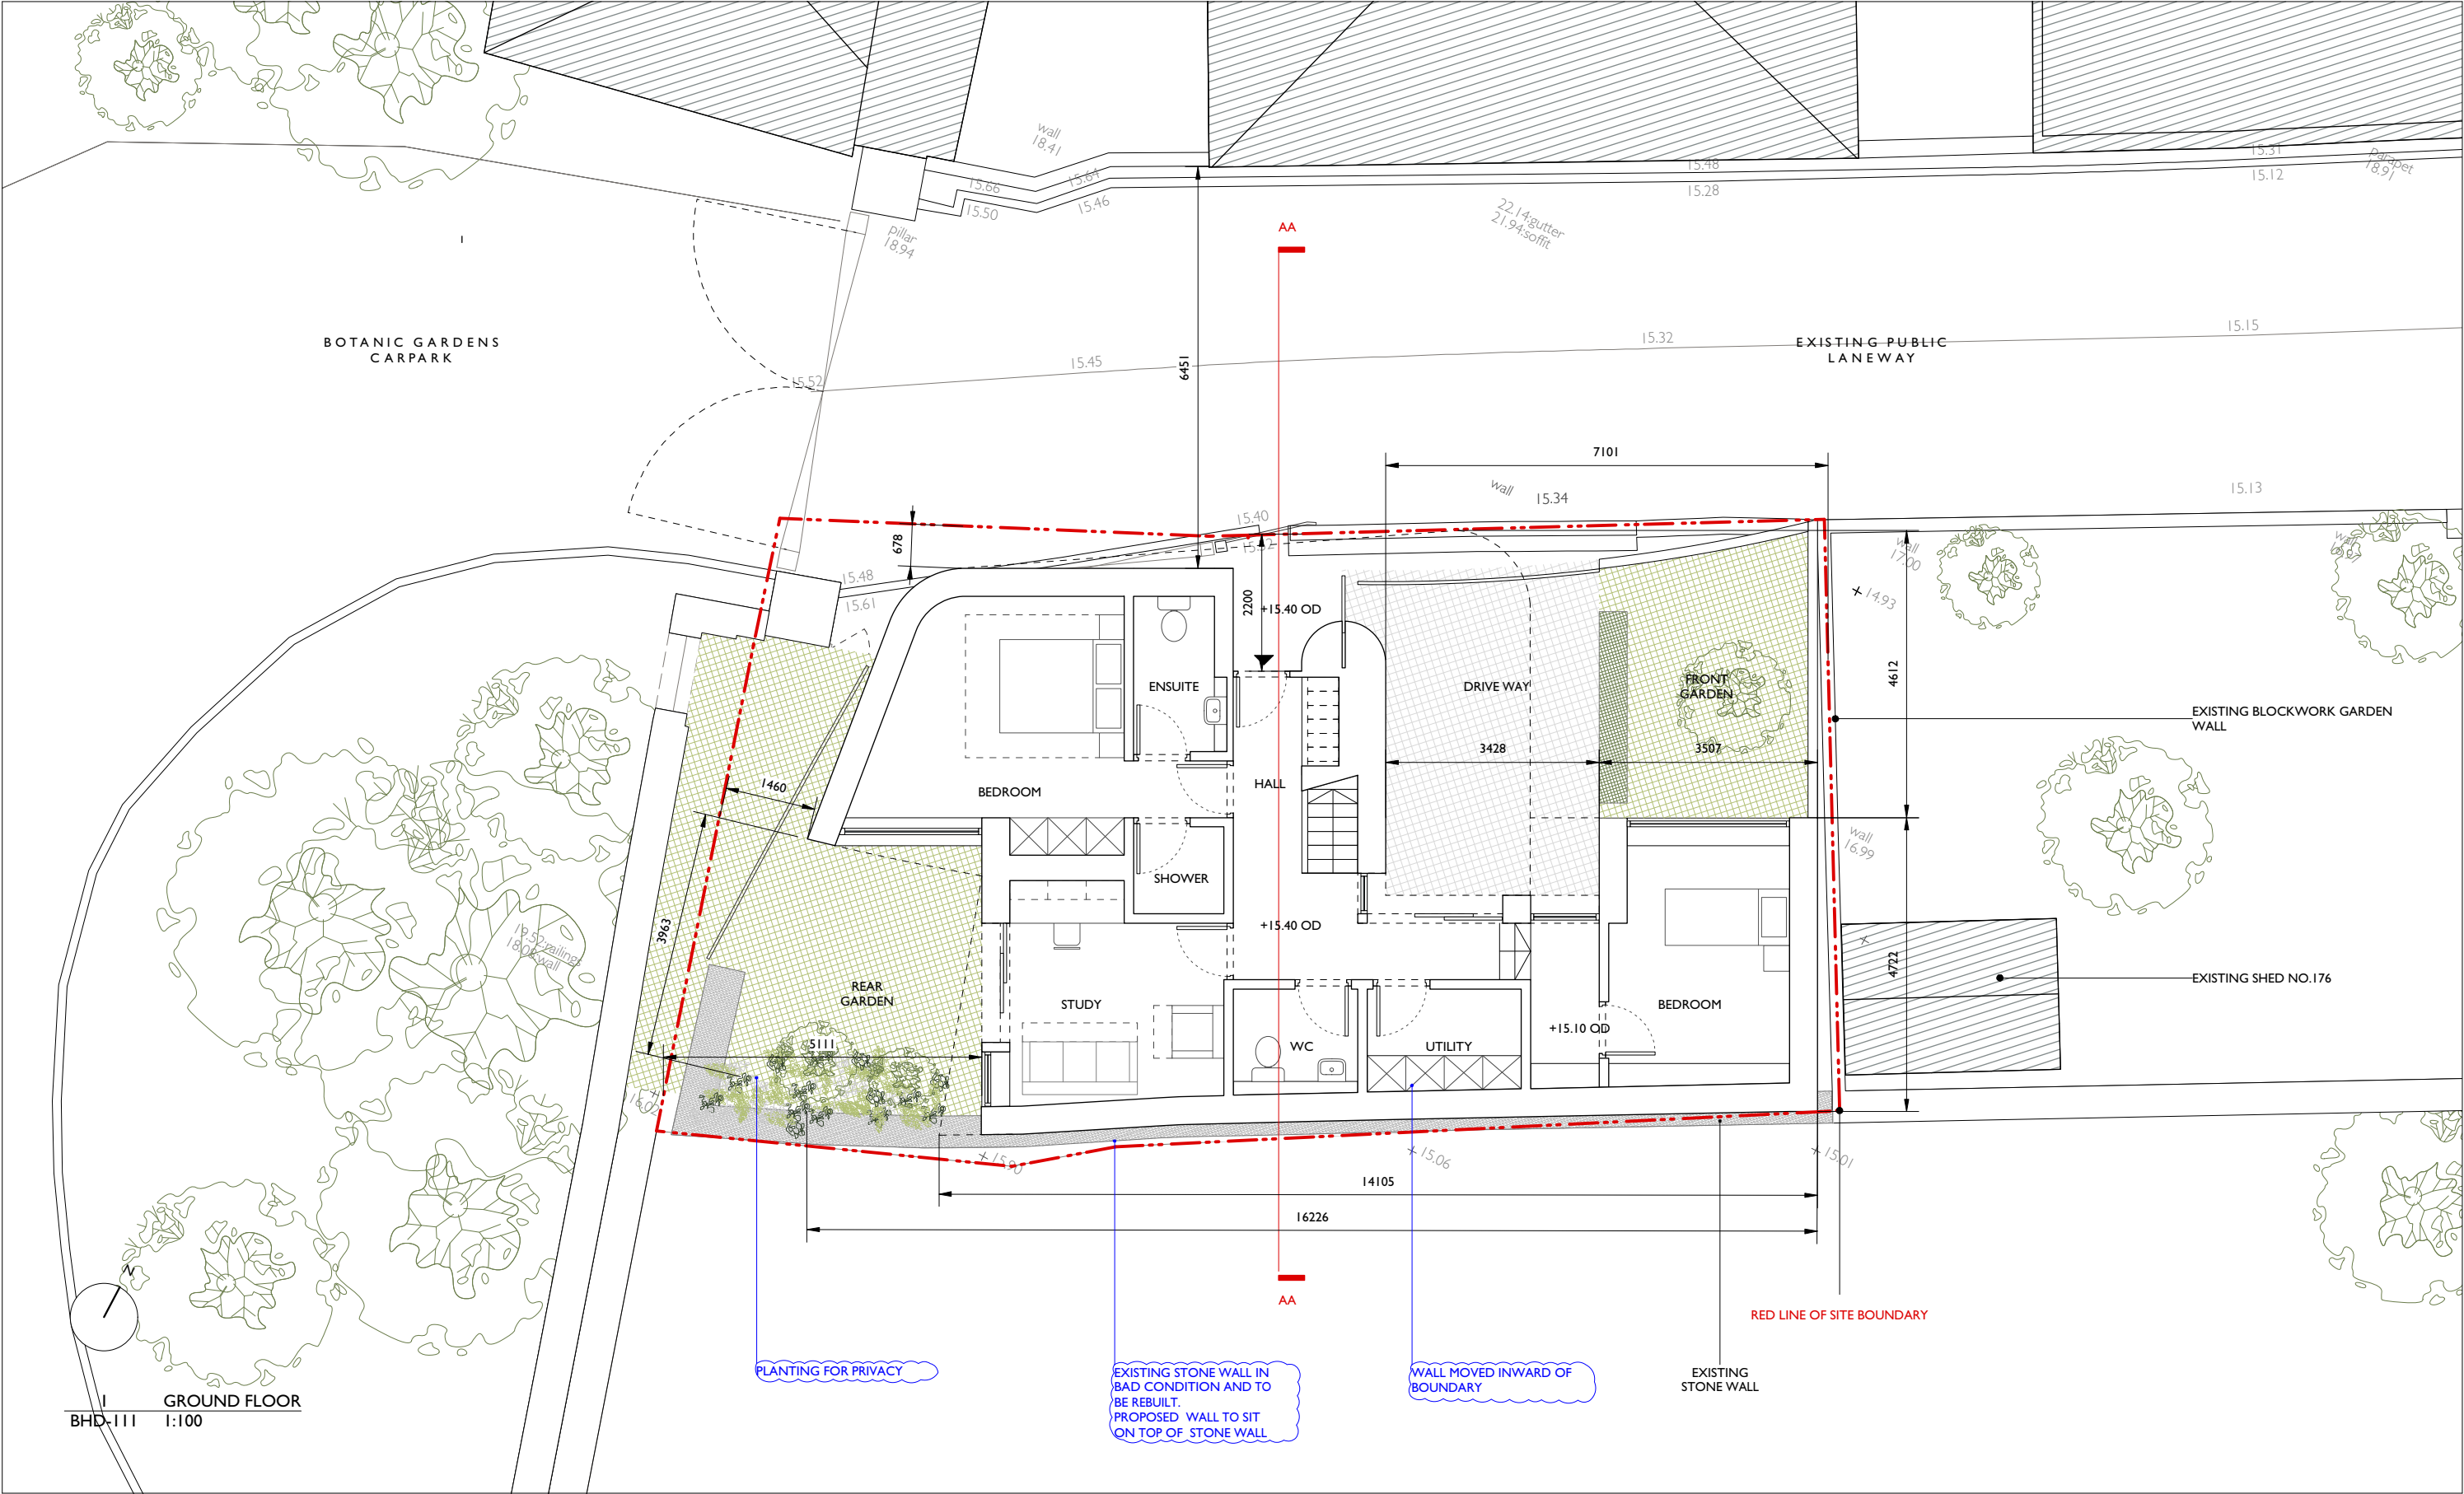

GENERAL NOTES AND COMMENTS

- Use figured dimensions only. Do not scale off hard copy or .dwg files.
- Check all dimensions on site.
- Notify the architect of any discrepancies immediately.
- Read all drawings in conjunction with the relevant architect's specifications and other design drawings and / or details for further information.

DISCLAIMER

This document is confidential and has been issued in accordance with our conditions of appointment solely for the use of the named client for the purposes of describing a design intent for a specific project and / or for the client entering into a building contract. All third parties should note that the document has been prepared for a specific client, brief, statutory regime and geographic location. Accordingly, the advice contained herein are **not** intended for any third parties and may have been amplified or amended by unidentified matters elsewhere described. Third parties should rely on their own current, independent, experienced professional advice. The document expressly does **not** provide any warranty whatsoever including as to the as-built conditions which could materially vary. mcgarry ní éanaigh architects expressly **disclaims** any and all liabilities to any and all third parties arising from this document. If you have received this document in error, please notify McGarry Ní Éanaigh architects immediately.

COPYRIGHT McGARRY NÍ ÉANAIGH ARCHITECTS TEO

REV:	DATE:	STATUS:	DRAWN:	APPROVED:	ISSUED:	TEXT:
B:	07.03.2019	FP	CF	MMCG	CF	PLANNING
C:	17.04.2019	FI	CF	MMDD	CF	STONE WALL SHOWN
D:	10.11.2019	FP	CF	MMCG	CF	RFI
FI:INFO FA:APPROVAL FP:PLANNING FT:TENDER FC:CONSTRUCTION						

TITLE: GROUND FLOOR PLAN


PROJECT: BOTANIC HOUSE DUBLIN
CLIENT: HUGH + SASKIA MCDONNELL
JOB NUMBER: 1609
SCALE: 1:100

DRAWING NUMBER:

BHD - 111

D
PLANNING

McGARRY NÍ ÉANAIGH ARCHITECTS
23 Mountjoy Square
Dublin 1 Ireland
+353 1 888 0840
info@mcgnie.ie www.mcgnie.ie

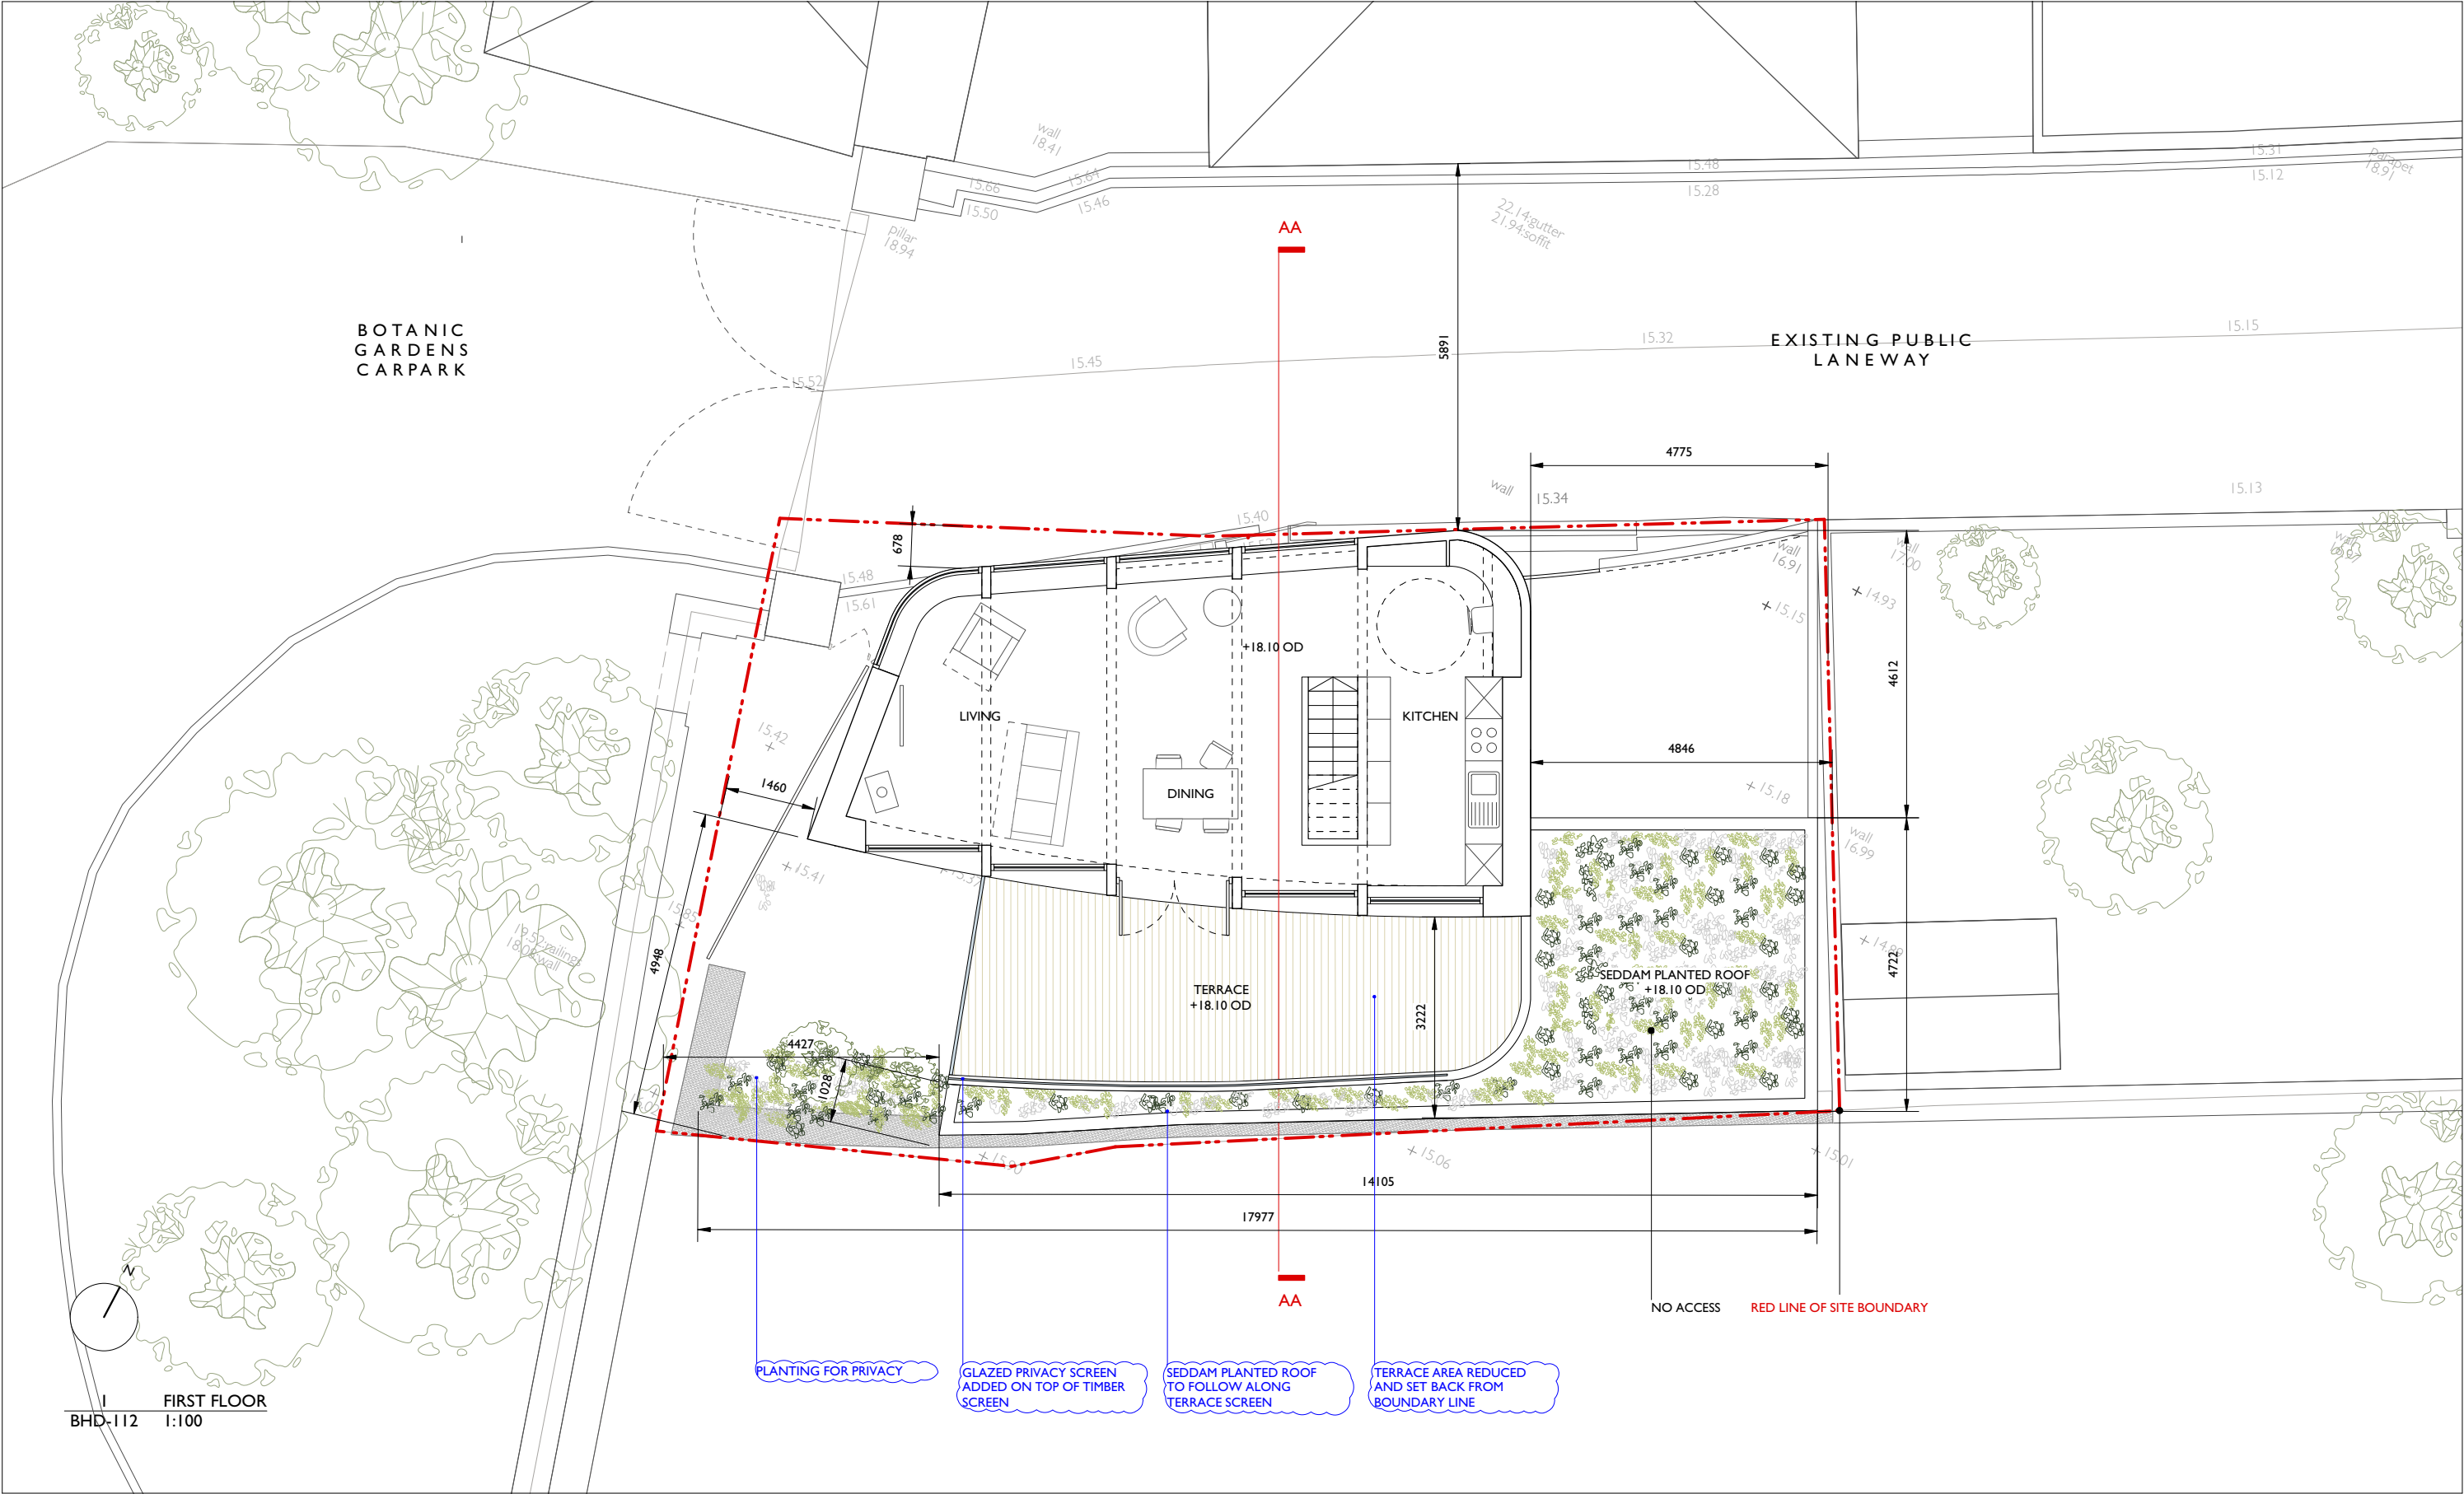

GENERAL NOTES AND COMMENTS

- Use figured dimensions only. Do not scale off hard copy or .dwg files.
- Check all dimensions on site.
- Notify the architect of any discrepancies immediately.
- Read all drawings in conjunction with the relevant architect's specifications and other design drawings and / or details for further information.

DISCLAIMER

This document is confidential and has been issued in accordance with our conditions of appointment solely for the use of the named client for the purposes of describing a design intent for a specific project and / or for the client entering into a building contract. All third parties should note that the document has been prepared for a specific client, brief, statutory regime and geographic location. Accordingly, the advice contained herein are **not** intended for any third parties and may have been amplified or amended by unidentified matters elsewhere described. Third parties should rely on their own current, independent, experienced professional advice. The document expressly does **not** provide any warranty whatsoever including as to the as-built conditions which could materially vary. mcgarry ní éanaigh architects expressly **disclaims** any and all liabilities to any and all third parties arising from this document. If you have received this document in error, please notify McGarry Ní Éanaigh architects immediately.

COPYRIGHT McGARRY NÍ ÉANAIGH ARCHITECTS TEO

REV:	DATE:	STATUS:	DRAWN:	APPROVED:	ISSUED:	TEXT:
B:	07.03.2019	FP	CF	MMCG	CF	PLANNING
C:	17.04.2019	FI	CF	MMDD	CF	STONE WALL SHOWN
D:	10.11.2019	FP	CF	MMCG	CF	RFI
FI:INFO FA:APPROVAL FP:PLANNING FT:TENDER FC:CONSTRUCTION						

TITLE: FIRST FLOOR PLAN


PROJECT: BOTANIC HOUSE DUBLIN
CLIENT: HUGH + SASKIA MCDONNELL

JOB NUMBER: 1609
SCALE: 1:100

DRAWING NUMBER:
BHD - 112

D
PLANNING

**McGARRY NÍ ÉANAIGH
ARCHITECTS**
23 Mountjoy Square
Dublin 1 Ireland
+353 1 888 0840
info@mcgnie.ie www.mcgnie.ie

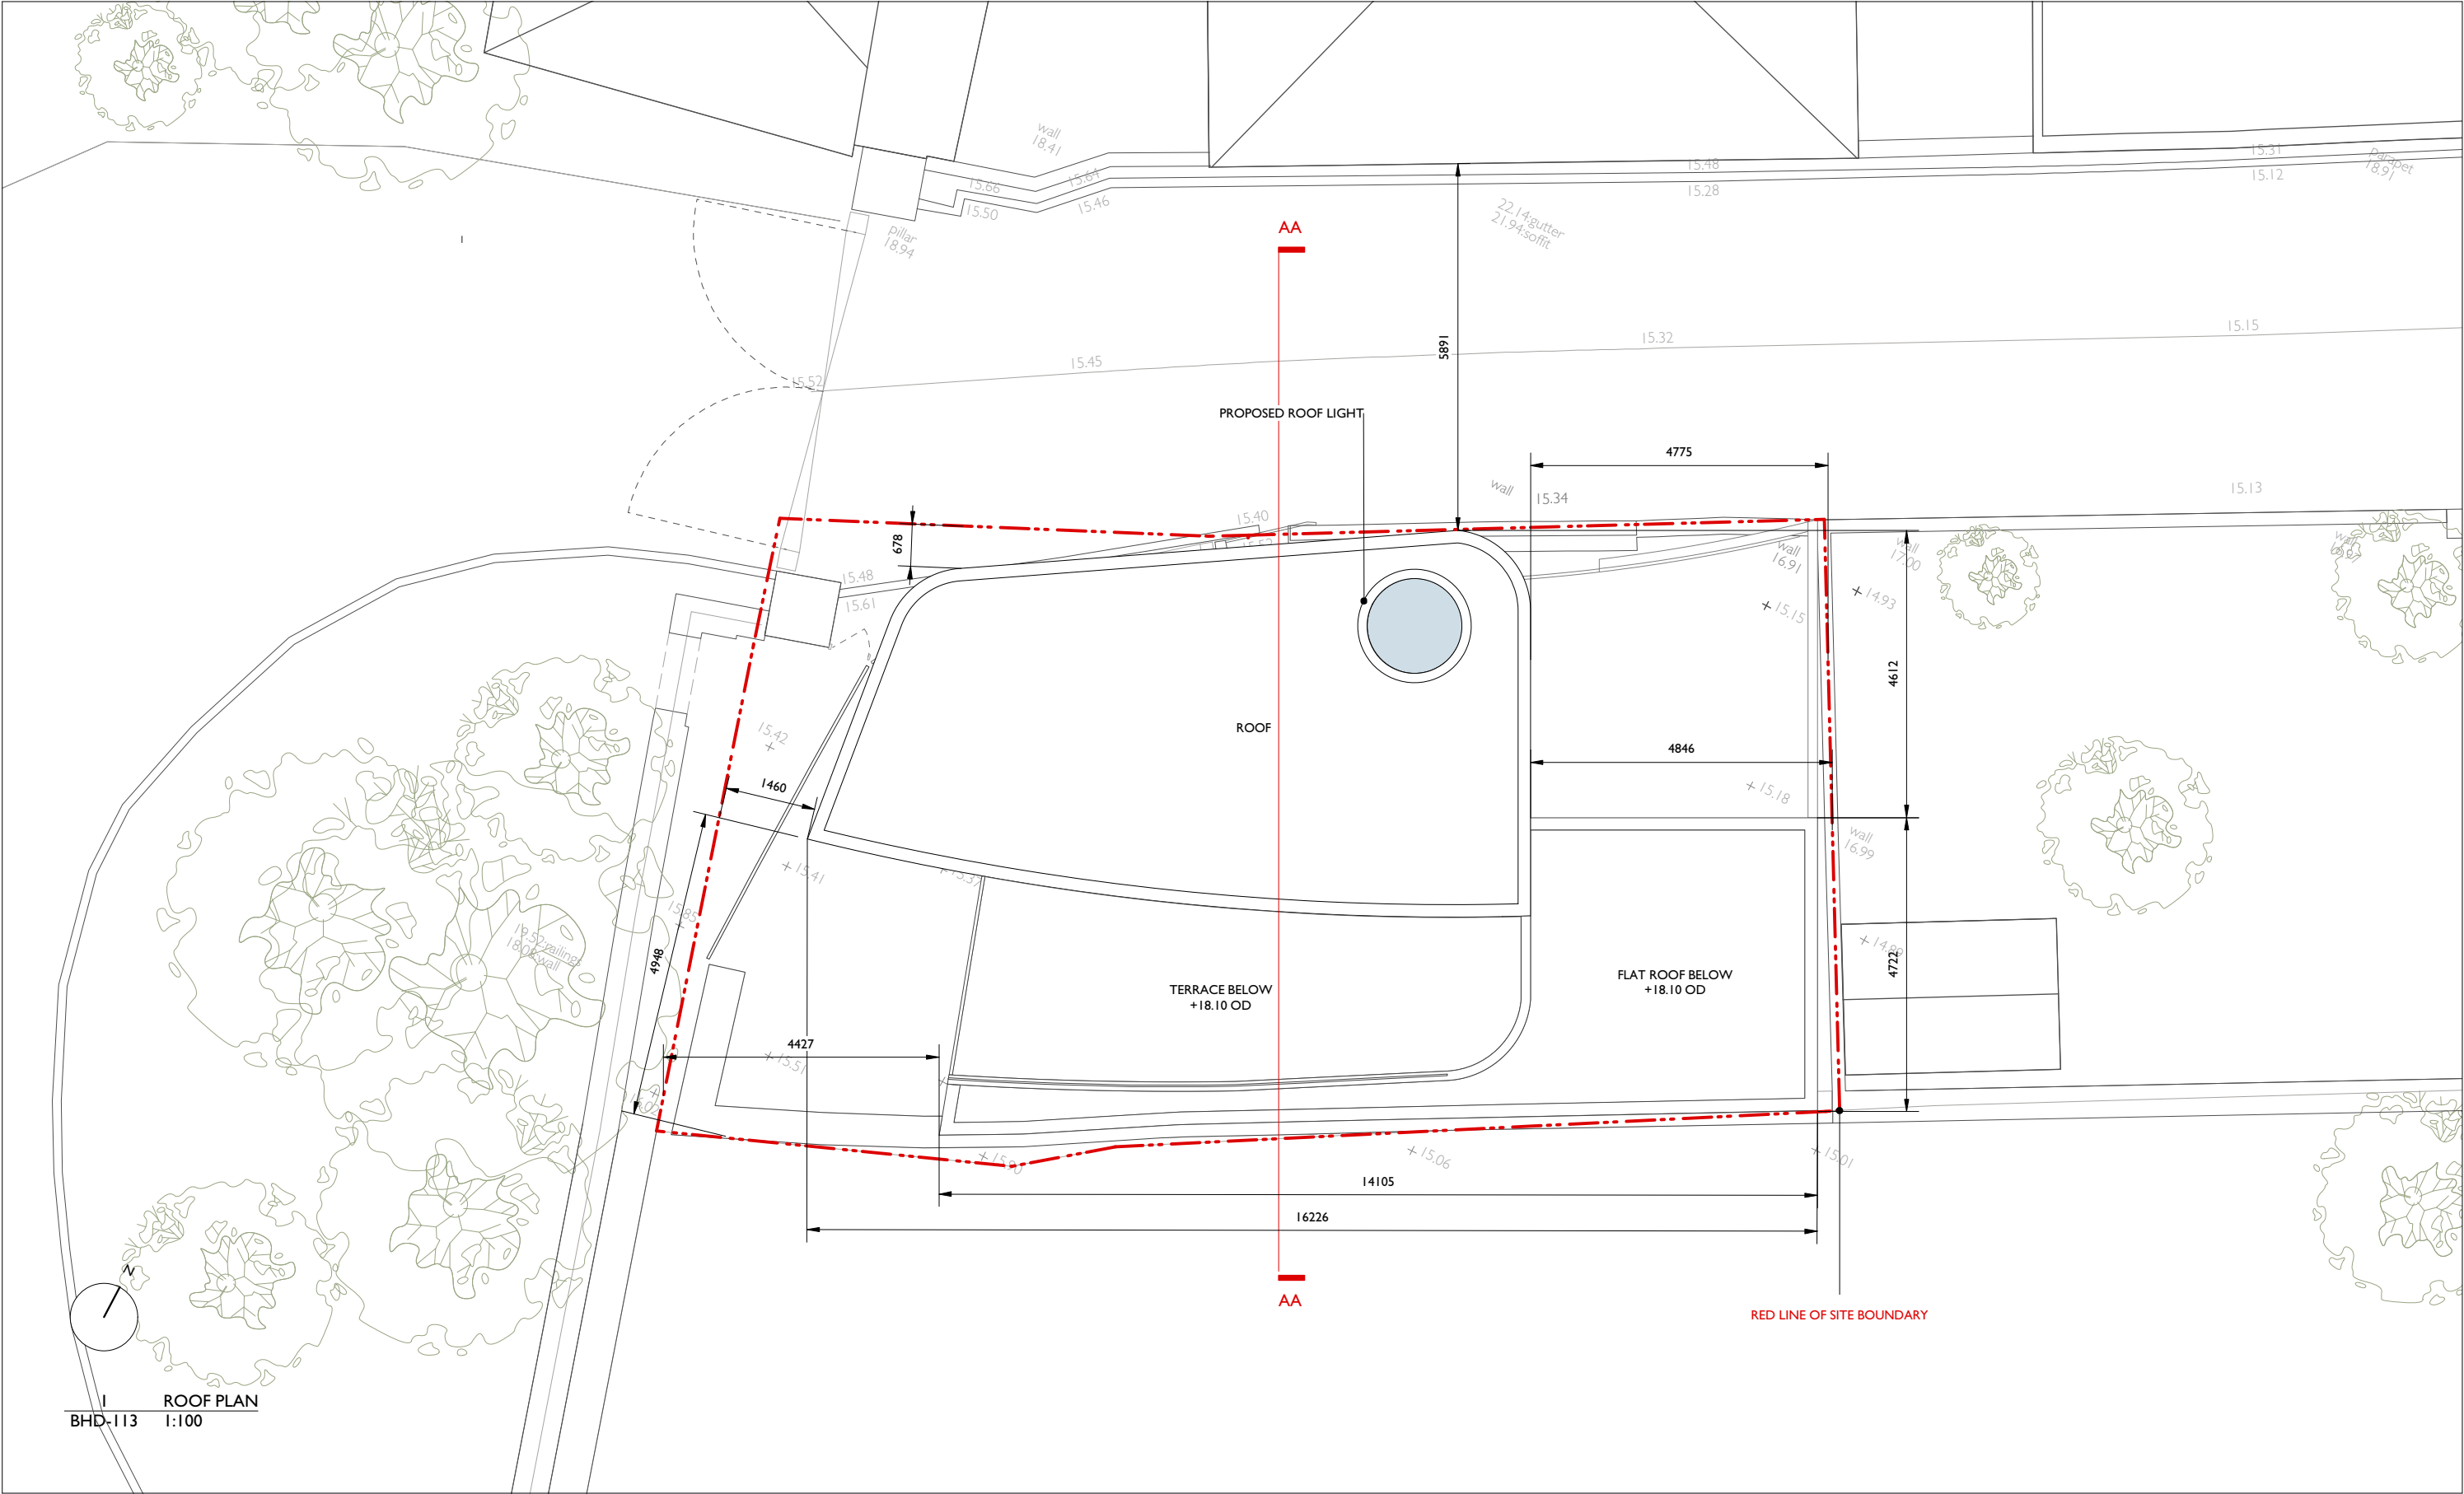

GENERAL NOTES AND COMMENTS

- Use figured dimensions only. Do not scale off hard copy or .dwg files.
- Check all dimensions on site.
- Notify the architect of any discrepancies immediately.
- Read all drawings in conjunction with the relevant architect's specifications and other design drawings and / or details for further information.

DISCLAIMER

This document is confidential and has been issued in accordance with our conditions of appointment solely for the use of the named client for the purposes of describing a design intent for a specific project and / or for the client entering into a building contract. All third parties should note that the document has been prepared for a specific client, brief, statutory regime and geographic location. Accordingly, the advice contained herein is **not** intended for any third parties and may have been amplified or amended by unidentified matters elsewhere described. Third parties should rely on their own current, independent, experienced professional advice. The document expressly does **not** provide any warranty whatsoever including as to the as-built conditions which could materially vary. mcgarry ní éanaigh architects expressly **disclaims** any and all liabilities to any and all third parties arising from this document. If you have received this document in error, please notify McGarry Ní Éanaigh architects immediately.

COPYRIGHT McGARRY NÍ ÉANAIGH ARCHITECTS TEO

REV:	DATE:	STATUS:	DRAWN:	APPROVED:	ISSUED:	TEXT:
B:	07.03.2019	FP	CF	MMCG	CF	PLANNING
C:	17.04.2019	FI	CF	MMDD	CF	STONE WALL SHOWN
D:	10.11.2019	FP	CF	MMCG	CF	RFI
FI:INFO FA:APPROVAL FP:PLANNING FT:TENDER FC:CONSTRUCTION						


TITLE: ROOF PLAN

PROJECT: BOTANIC HOUSE DUBLIN
CLIENT: HUGH + SASKIA MCDONNELL
JOB NUMBER: 1609
SCALE: 1:100

DRAWING NUMBER:
BHD - 113

D
PLANNING

McGARRY NÍ ÉANAIGH
ARCHITECTS
23 Mountjoy Square
Dublin 1 Ireland
+353 1 888 0840
info@mcgnie.ie www.mcgnie.ie

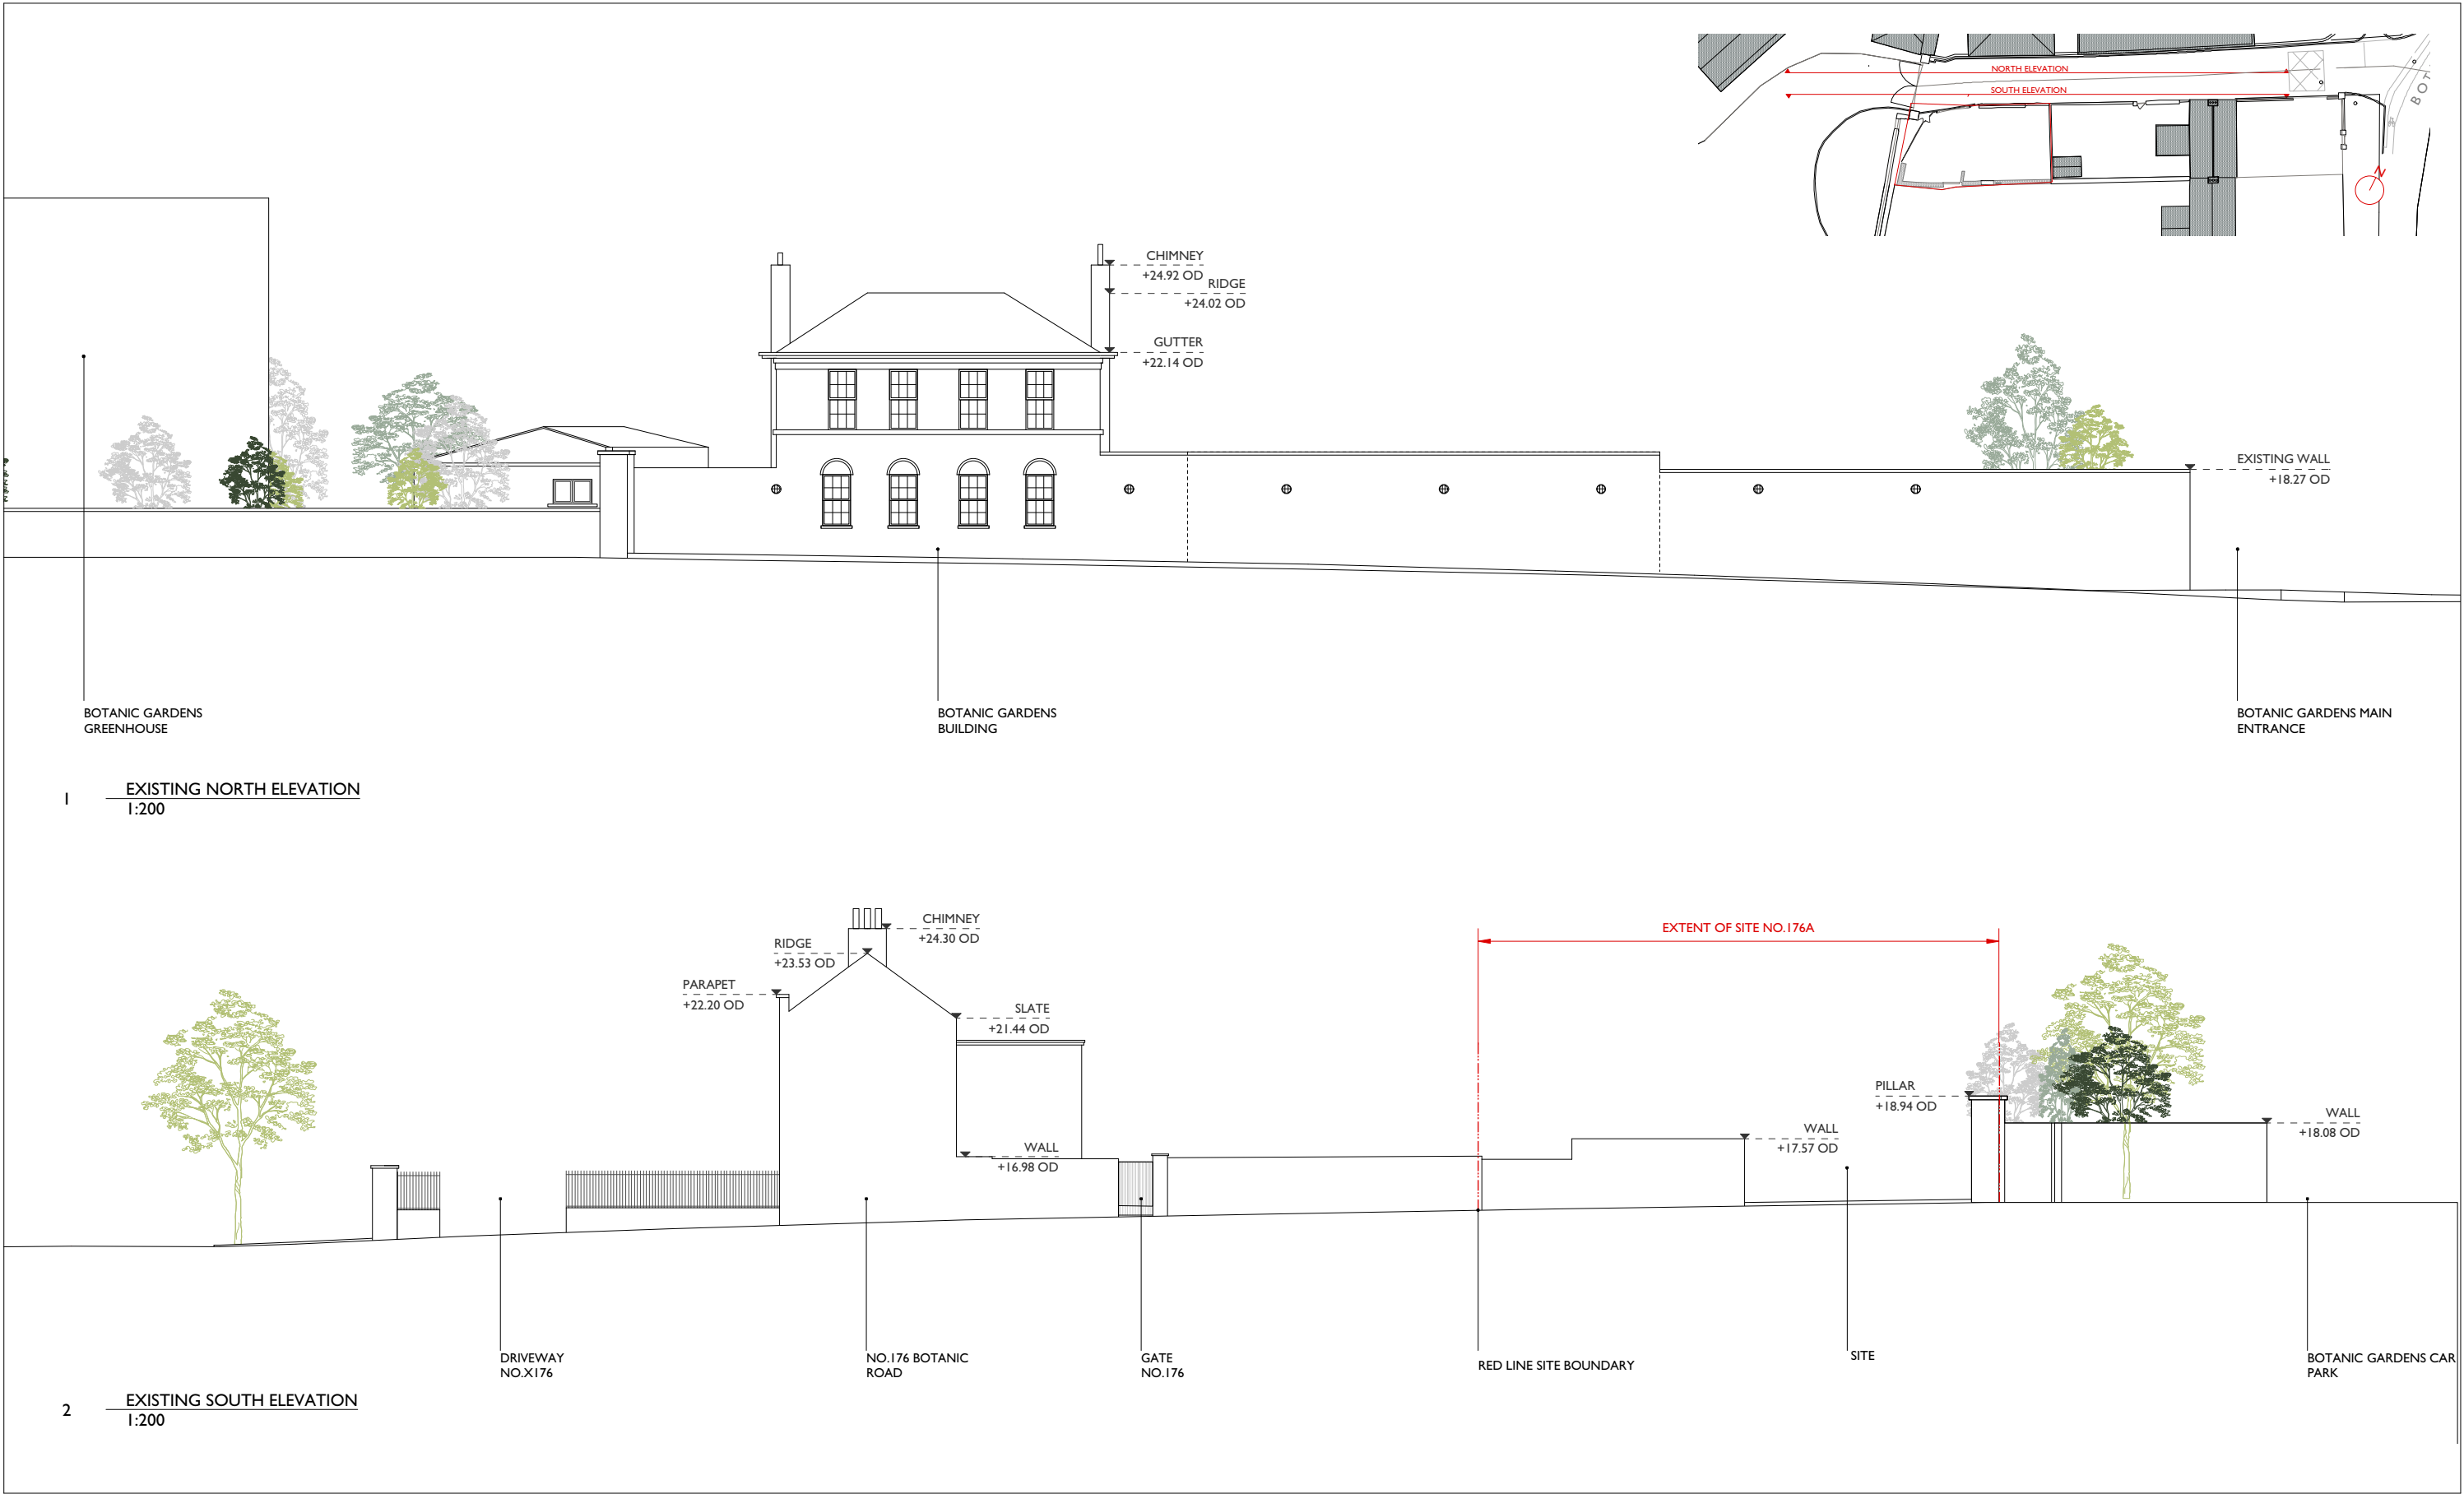

GENERAL NOTES AND COMMENTS

- Use figured dimensions only. Do not scale off hard copy or .dwg files.
- Check all dimensions on site.
- Notify the architect of any discrepancies immediately.
- Read all drawings in conjunction with the relevant architect's specifications and other design drawings and / or details for further information.

DISCLAIMER

This document is confidential and has been issued in accordance with our conditions of appointment solely for the use of the named client for the purposes of describing a design intent for a specific project and / or for the client entering into a building contract. All third parties should note that the document has been prepared for a specific client, brief, statutory regime and geographic location. Accordingly, the advice contained herein is **not** intended for any third parties and may have been amplified or amended by unidentified matters elsewhere described. Third parties should rely on their own current, independent, experienced professional advice. The document expressly does **not** provide any warranty whatsoever including as to the as-built conditions which could materially vary. mcgarry ní éanaigh architects expressly **disclaims** any and all liabilities to any and all third parties arising from this document. if you have received this document in error, please notify McGarry Ní Éanaigh architects immediately.

COPYRIGHT MCGARRY NÍ ÉANAIGH ARCHITECTS TEO

REV:	DATE:	STATUS:	DRAWN:	APPROVED:	ISSUED:	TEXT:
B:	11.12.2018	FI	CF	MMCG		FOR INFO
C:	07.03.2019	FP	CF	MMCG	CF	PLANNING
D:						
FI:INFO FA:APPROVAL FP:PLANNING FT:TENDER FC:CONSTRUCTION						




TITLE: EXISTING SITE ELEVATIONS

PROJECT: BOTANIC HOUSE DUBLIN
CLIENT: HUGH + SASKIA MCDONNELL
JOB NUMBER: 1609
SCALE: 1:200

DRAWING NUMBER:
BHD - 200

B
revision

MCGARRY NÍ ÉANAIGH
ARCHITECTS
23 Mountjoy Square
Dublin 1 Ireland
+353 1 888 0840
info@mcgnie.ie www.mcgnie.ie

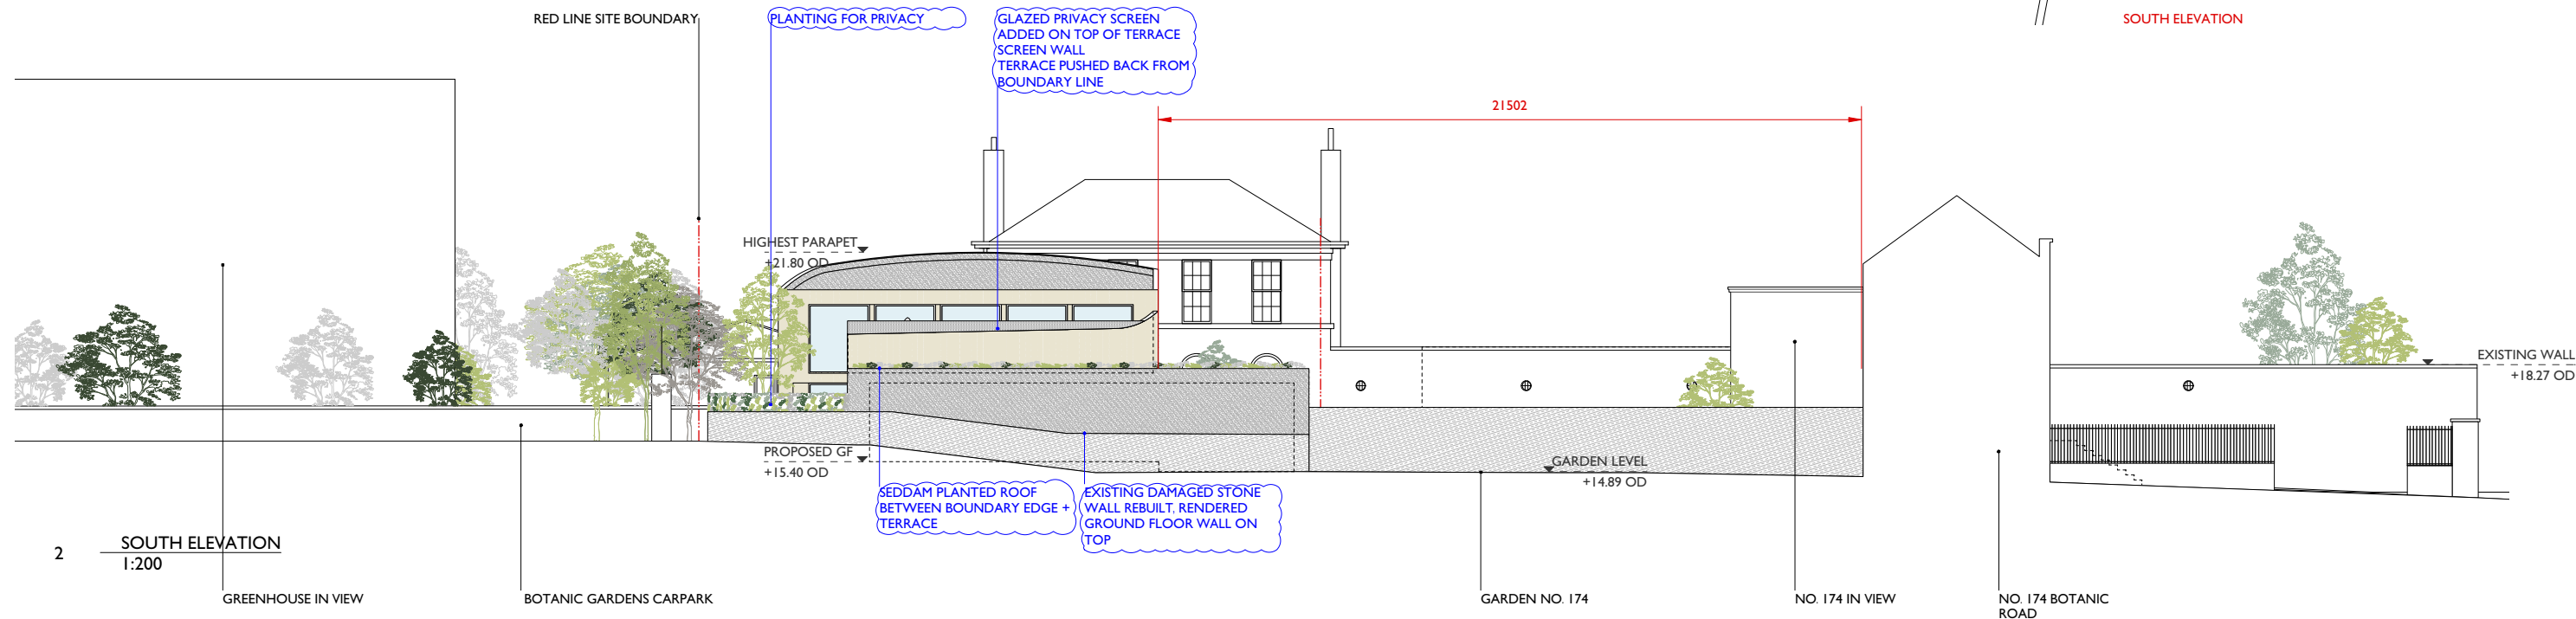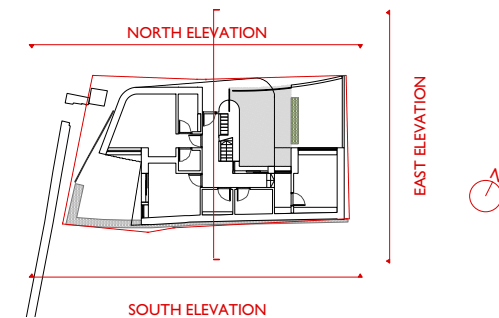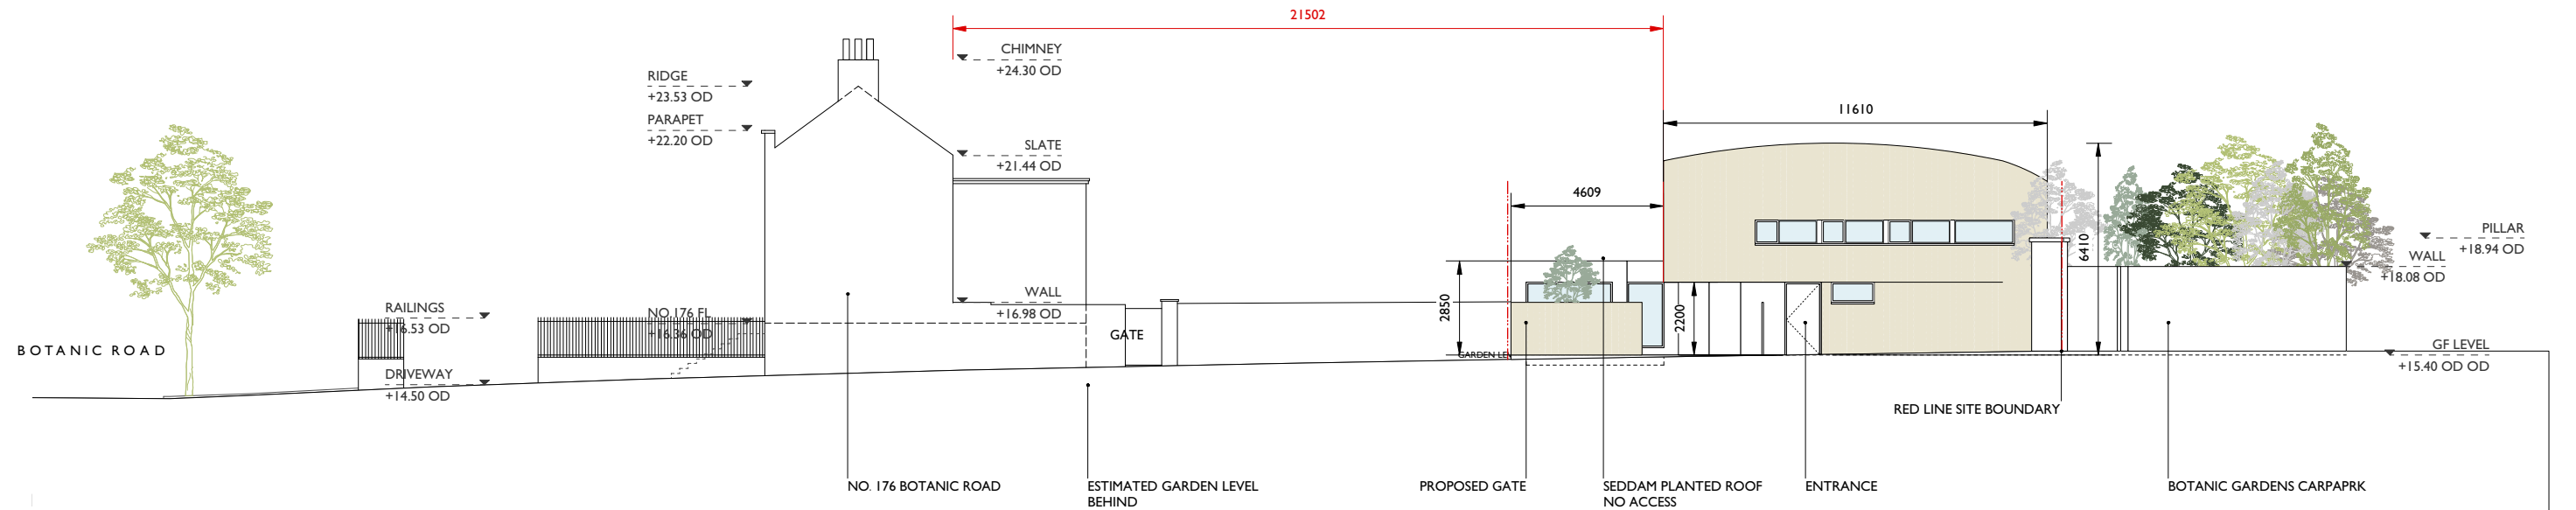

GENERAL NOTES AND COMMENTS

- Use figured dimensions only. Do not scale off hard copy or .dwg files.
- Check all dimensions on site.
- Notify the architect of any discrepancies immediately.
- Read all drawings in conjunction with the relevant architect's specifications and other design drawings and / or details for further information.

DISCLAIMER

This document is confidential and has been issued in accordance with our conditions of appointment solely for the use of the named client for the purposes of describing a design intent for a specific project and / or for the client entering into a building contract. All third parties should note that the document has been prepared for a specific client brief, statutory regime and geographic location. Accordingly, the advice contained herein are **not** intended for any third parties and may have been amplified or amended by unidentified matters elsewhere described. Third parties should rely on their own current, independent, experienced professional advice. The document expressly does **not** provide any warranty whatsoever including as to the as-built conditions which could materially vary. mcgarry ní éanaigh architects expressly **disclaims** any and all liabilities to any and all third parties arising from this document. if you have received this document in error, please notify McGarry Ní Éanaigh architects immediately.

COPYRIGHT MCGARRY NÍ ÉANAIGH ARCHITECTS TEO

REV:	DATE:	STATUS:	DRAWN:	APPROVED:	ISSUED:	TEXT:
B:	06.02.2019	FI	CF	MMCG		
C:	07.03.2019	FP	CF	MMCG	CF	PLANNING
D:	10.11.2019	FP	CF	MMCG	CF	RFI
FI:INFO FA:APPROVAL FP:PLANNING FT:TENDER FC:CONSTRUCTION						

TITLE: PROPOSED ELEVATIONS

PROJECT: BOTANIC HOUSE DUBLIN
CLIENT: HUGH + SASKIA MCDONNELL





JOB NUMBER: 1609
SCALE: 1:200

DRAWING NUMBER:

BHD - 220

D
revision

McGARRY NÍ ÉANAIGH
ARCHITECTS
23 Mountjoy Square
Dublin 1 Ireland
+353 1 888 0840
info@mcgnie.ie www.mcgnie.ie

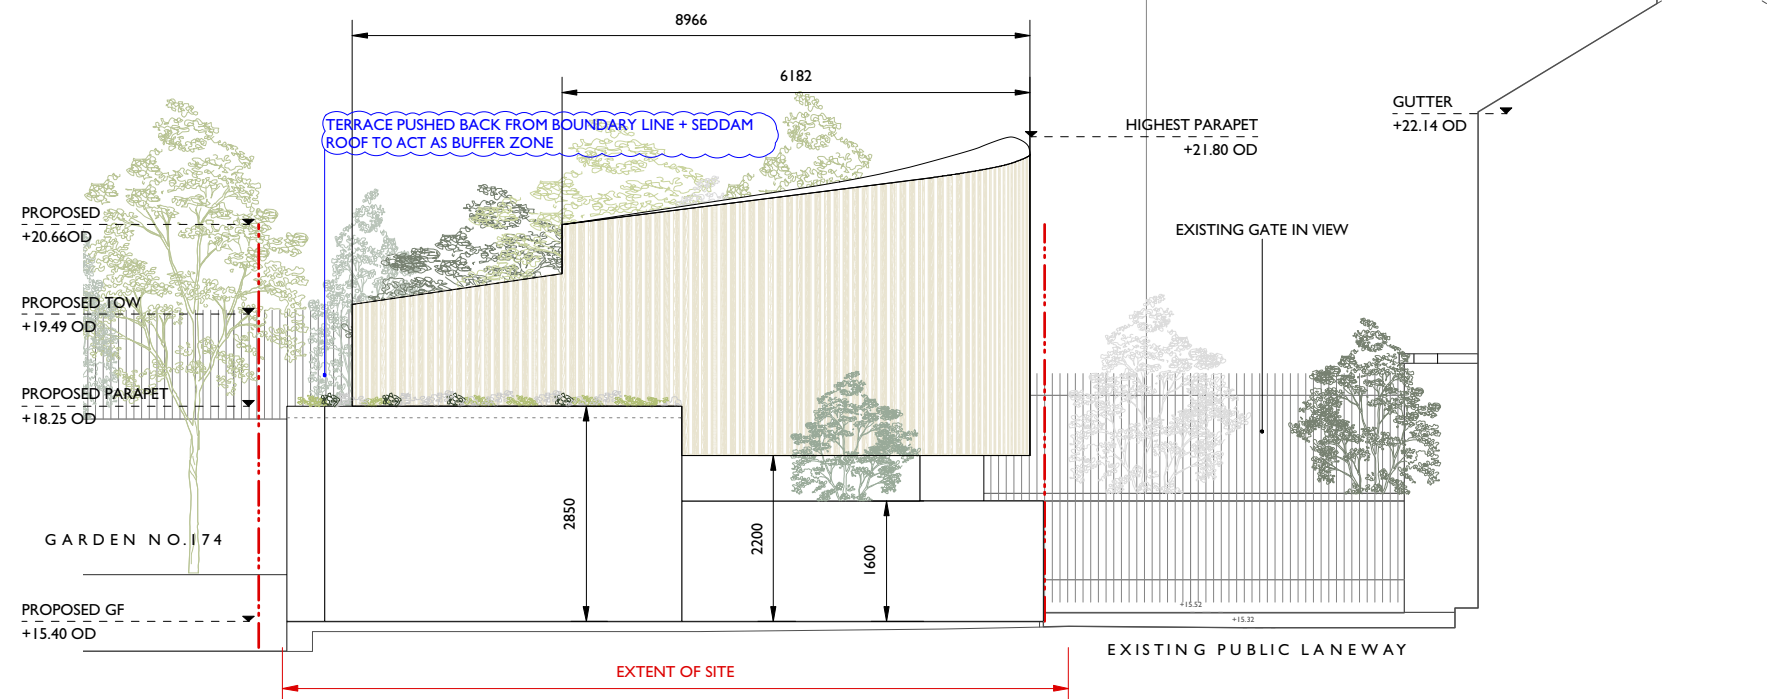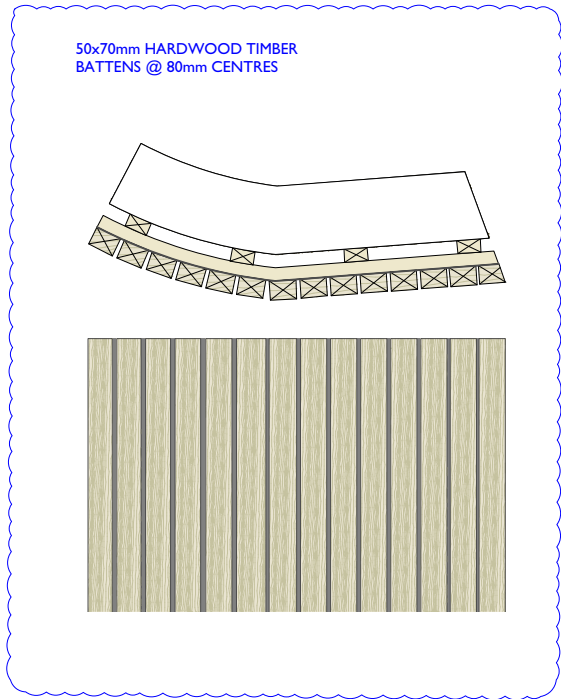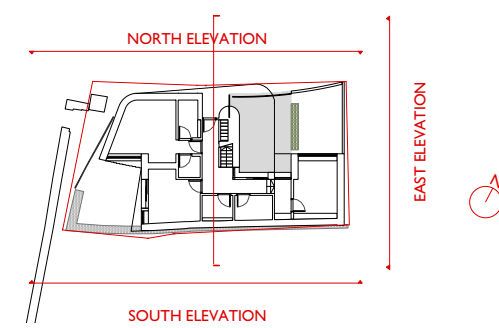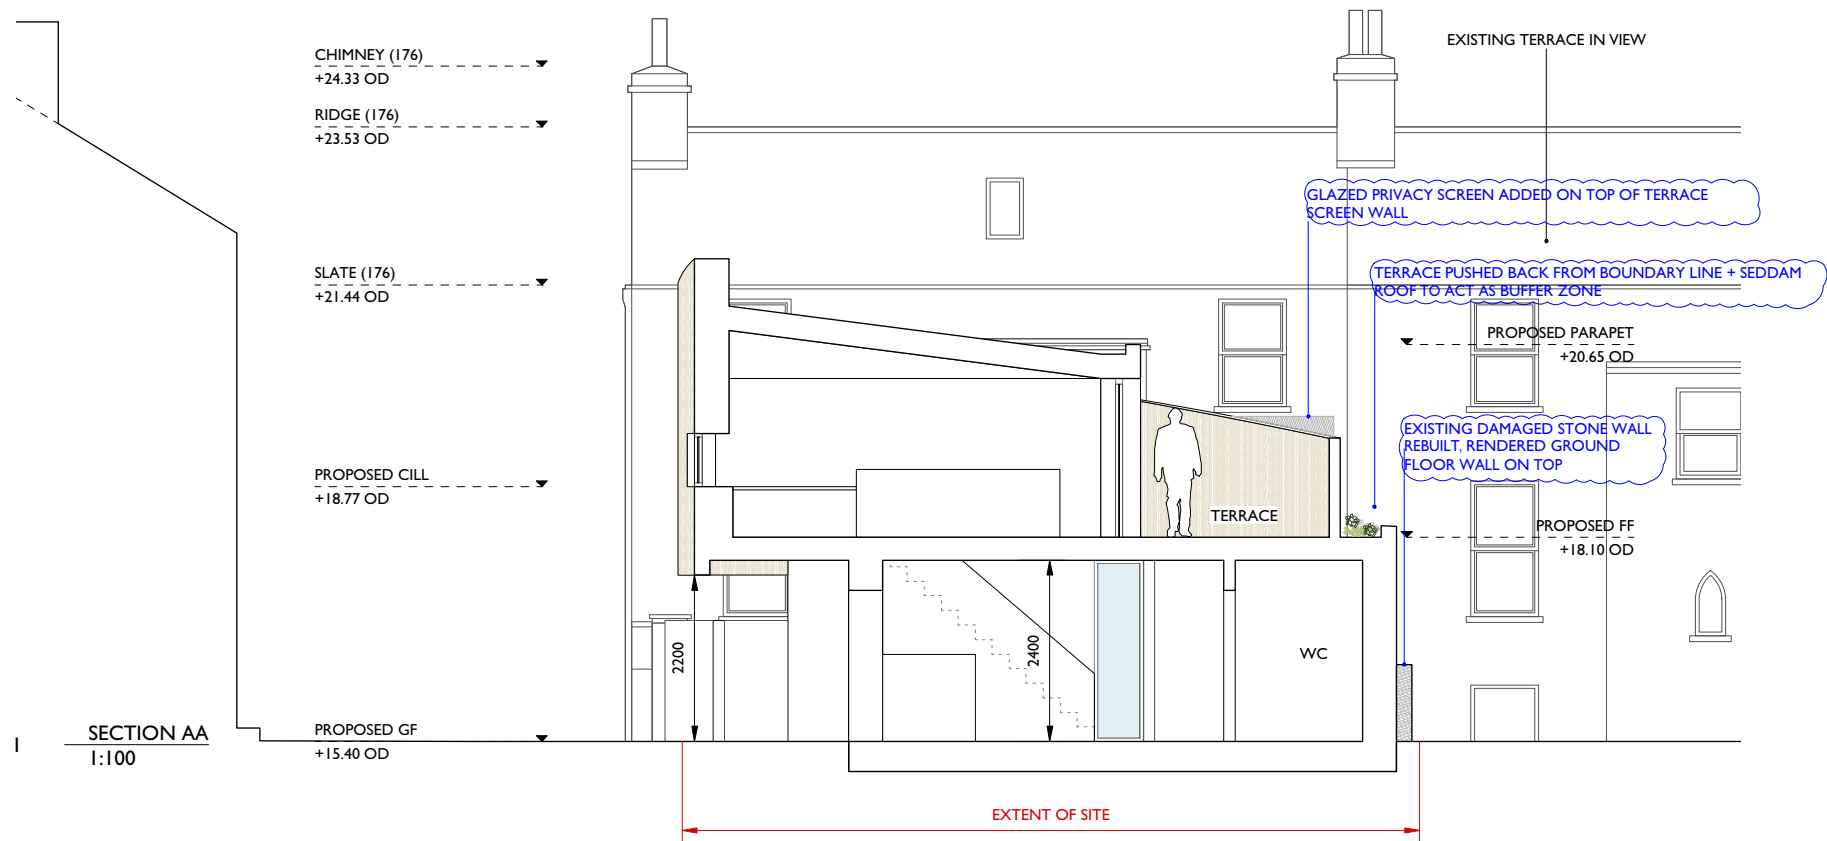

3 CLADDING DETAIL
1:20

2 EAST ELEVATION
1:100

GENERAL NOTES AND COMMENTS

- Use figured dimensions only. Do not scale off hard copy or .dwg files.
- Check all dimensions on site.
- Notify the architect of any discrepancies immediately.
- Read all drawings in conjunction with the relevant architect's specifications and other design drawings and / or details for further information.

DISCLAIMER

This document is confidential and has been issued in accordance with our conditions of appointment solely for the use of the named client for the purposes of describing a design intent for a specific project and / or for the client entering into a building contract. All third parties should note that the document has been prepared for a specific client, brief, statutory regime and geographic location. Accordingly, the advice contained herein is **not** intended for any third parties and may have been amplified or amended by unidentified matters elsewhere described. Third parties should rely on their own current, independent, experienced professional advice. The document expressly does **not** provide any warranty whatsoever including as to the as-built conditions which could materially vary.

mcgarry ní éanaigh architects expressly **disclaims** any and all liabilities to any and all third parties arising from this document. If you have received this document in error, please notify McGarry Ní Éanaigh architects immediately.

REV:	DATE:	STATUS:	DRAWN:	APPROVED:	ISSUED:	TEXT:
B:	06.02.2019	FI	CF	MMCG		
C:	07.03.2019	FP	CF	MMCG	CF	PLANNING
D:	10.11.2019	FP	CF	MMCG	CF	RFI
FI:INFO FA:APPROVAL FP:PLANNING FT:TENDER FC:CONSTRUCTION						

TITLE: PROPOSED SECTION + ELEVATION

PROJECT: BOTANIC HOUSE DUBLIN

CLIENT: HUGH + SASKIA MCDONNELL

JOB NUMBER: 1609

SCALE: 1:100

DRAWING NUMBER:
BHD - 230

D
revision

McGARRY NÍ ÉANAIGH ARCHITECTS
23 Mountjoy Square
Dublin 1 Ireland
+353 1 888 0840
info@mcgnie.ie www.mcgnie.ie