


EXHIBIT

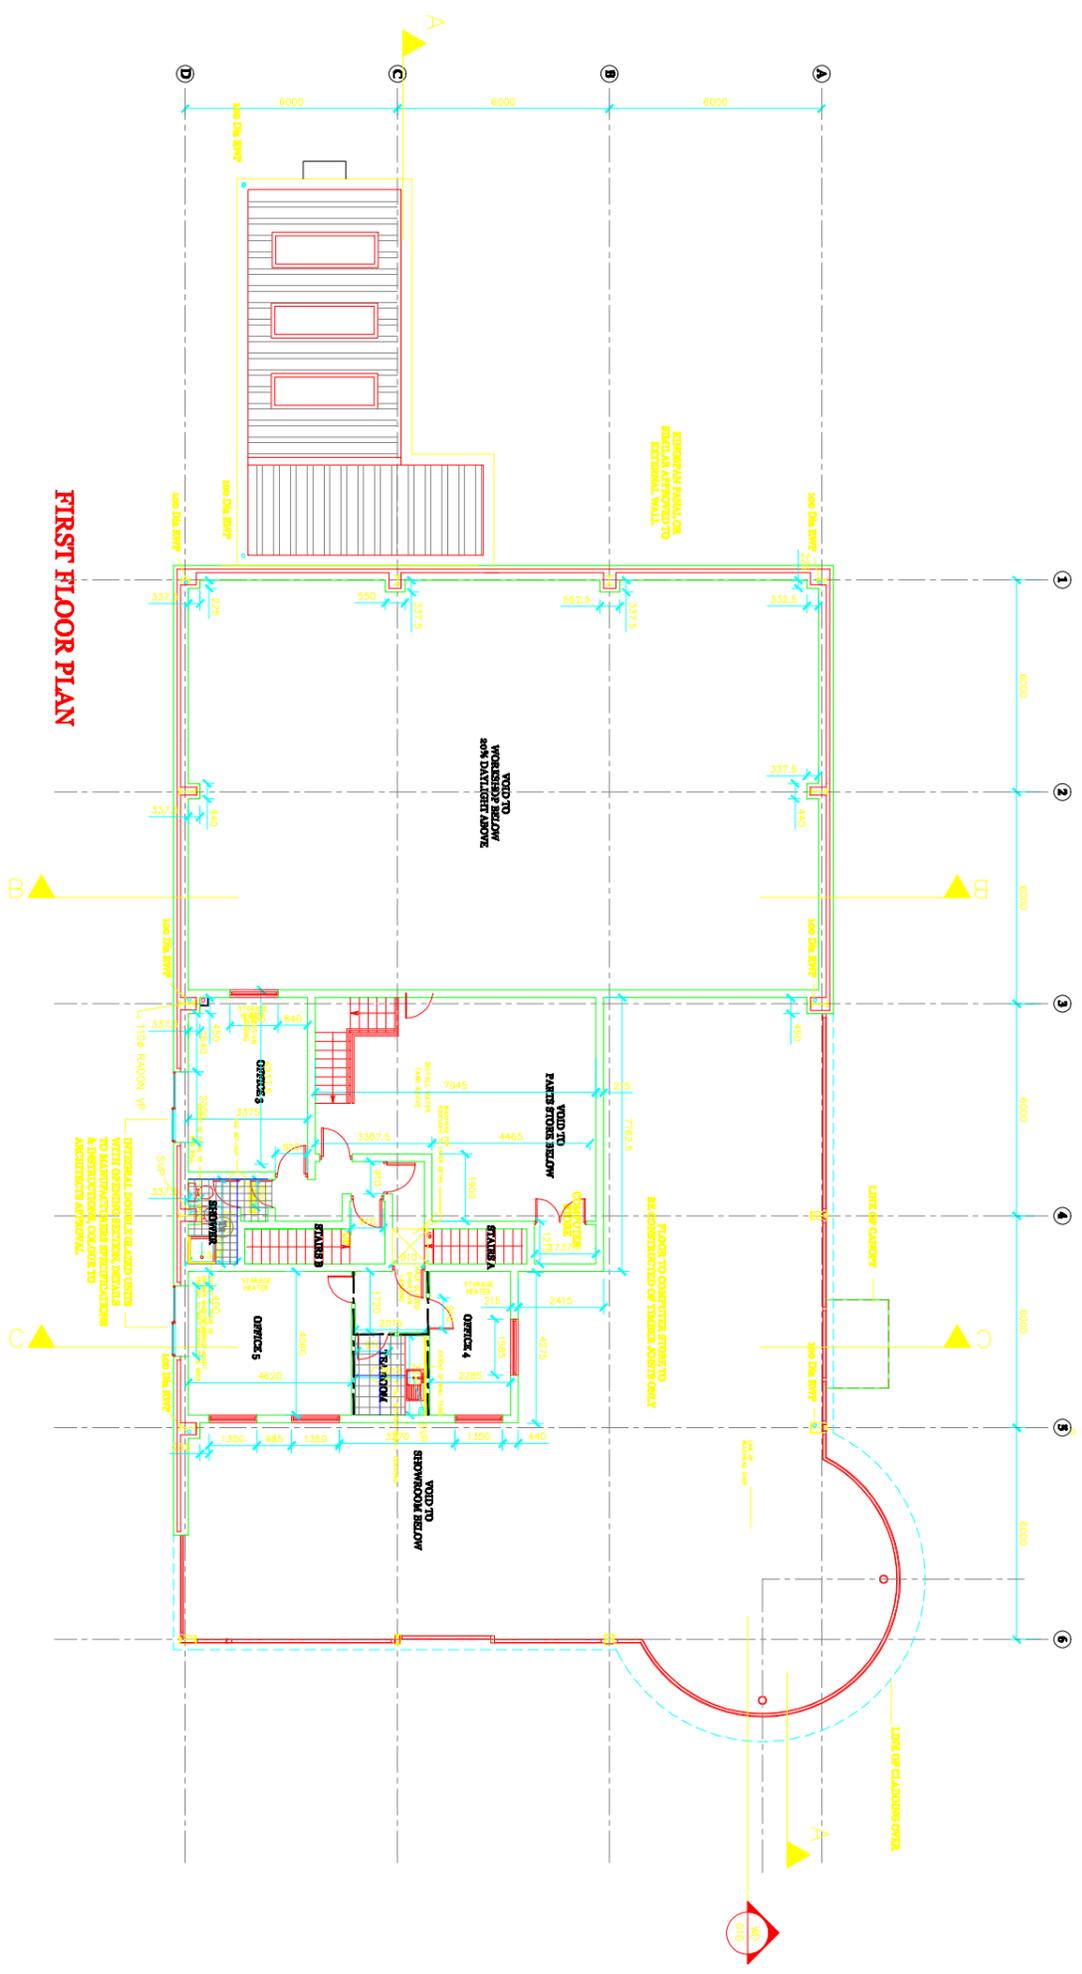

**FIRST FLOOR PLAN**

**AS BUILT DRAWING**  
20-03-02

D	INTEGRAL WINDOWS ADDED	07-08-01
C	STUD PARTITIONS ADDED;	07/06/01
B	ROOFLIGHT LOCATION ALTERED	
B	WINDOW ADDED/DOOR OPES AMENDED	25/4/01
A	SHOWER ADDED IN TOILET AREA	3/4/01
	STAIR LOBBY ALTERED	
	Removal of stair in stair parts room	
	UPPER PARTS STORE REMOVED	

**Project:** MOTOR SHOWROOM NEWLANDS CROSS  
**Title:** FIRST FLOOR PLAN

**The Priors**  
John Street West  
Tel: 01 6796466  
Fax: 01 6796733  
E-mail: info@projarch.com

**ProjArch**  
architects

Dwg No:	L005-WD-005	Issue:	WD	Rev:	
Scale:	1:100	Dwn by:	CKD	Date:	MARCH 200
<b>Client:</b> GLENULLEN DEVELOPMENTS					