




175613-27/06/2017-Domestic Garage Floor


Planning Department  
27 JUN 2017  
Cork County Council  
County Hall  
Cork.

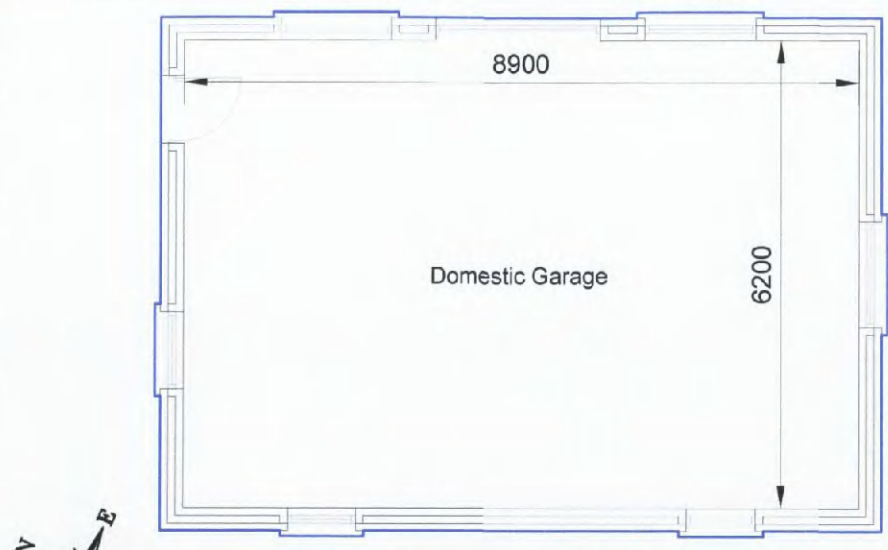

Existing Floor Plan  
(Scale 1:100)




Existing Front Elevation  
(Scale 1:100)

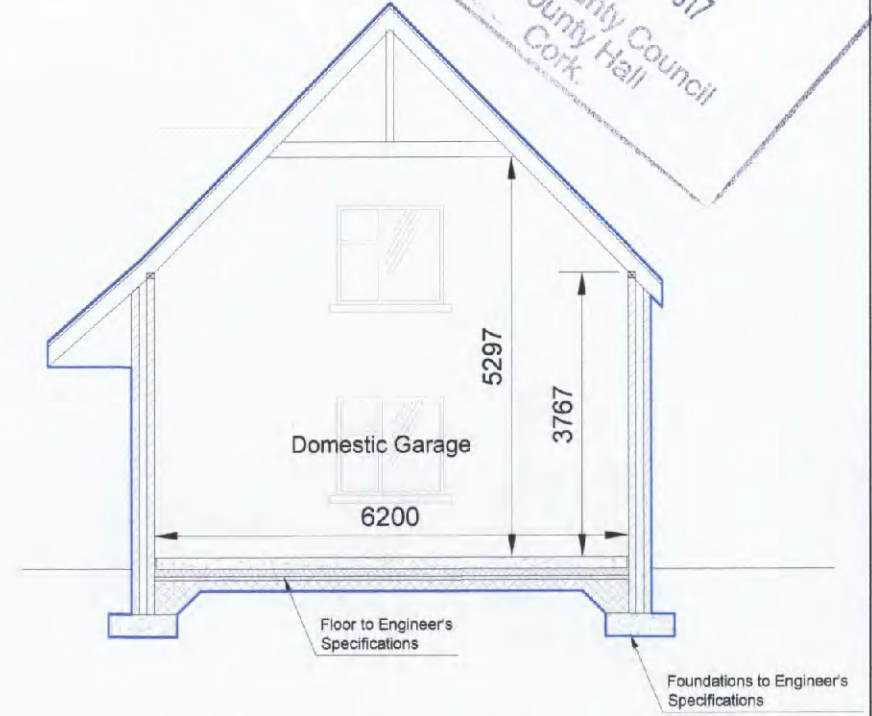

Typical Section (Existing)  
(Scale 1:100)



Existing Rear Elevation  
(Scale 1:100)

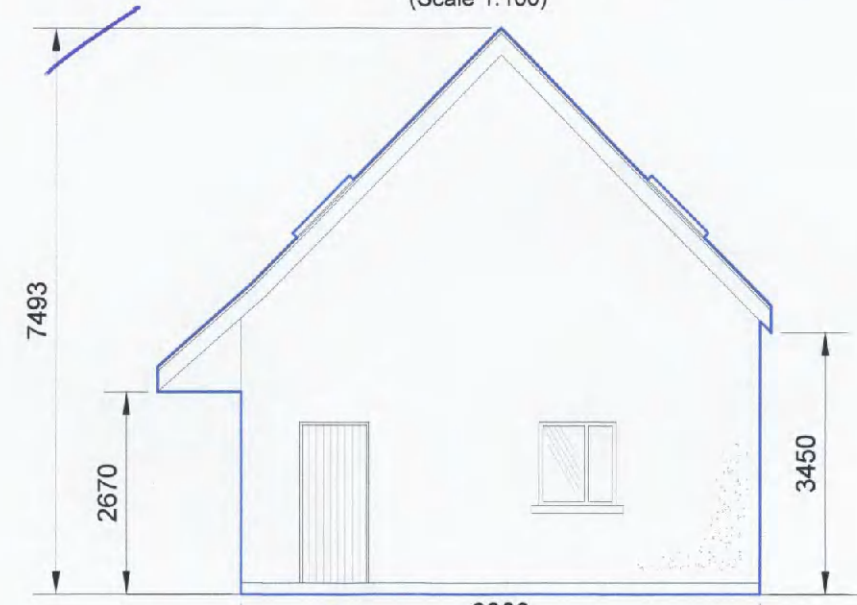

Existing Side Elevation  
(Scale 1:100)



Existing Side Elevation  
(Scale 1:100)

**Existing Finishes:**  
Blue/black roof slates.  
White upvc windows and doors.  
Medium texture sand & cement render to front, rear & side elevations.  
Smooth plaster plinth.  
White upvc fascia,soffit and rainwater goods.

Floor Area = 55.2 sq.m

<b>HARRINGTON O'FLYNN LTD CONSULTING ENGINEERS</b>	
16 Rose Lane, Tel: 021-4636760 Ballinacurra, Fax: 021-4636701 Midleton, Co. Cork. Email: hofce@eircom.net	
Clients: <b>Niall Wiseman</b>	
Job Title: Retention of dwellinghouse and garage as constructed at Kilboy, Ballyfeard, Carrigaline, Co. Cork.	
Drawing Title: Existing Domestic Garage Floor Plans, Elevations & Typical Section	
Drawing Scale: 1:100	Date: June 2017
Drawing Number: NW-PP-05	Drawing Issue: Planning
Drawn By: PH	Checked By: HOF