


1. All dimensions shown on this plan are to the face of the wall unless otherwise stated. All dimensions are to be taken from the finished floor level unless otherwise stated. All dimensions are to be taken from the finished floor level unless otherwise stated. All dimensions are to be taken from the finished floor level unless otherwise stated.

COMMERCIAL UNIT

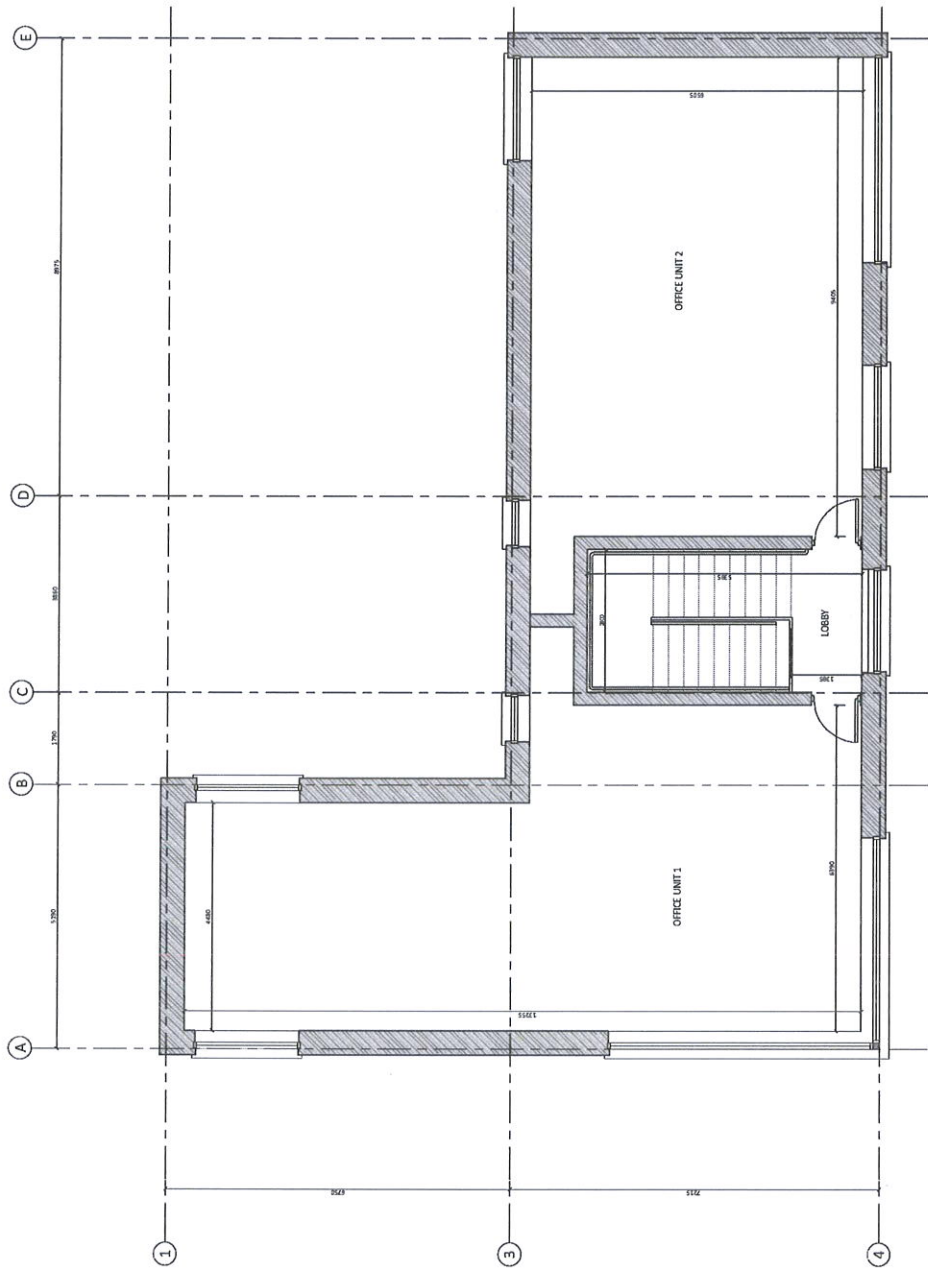

FIRST FLOOR PLAN  
1:50

FLOOR AREA

FLOOR	AREA	PERCENTAGE
FIRST FLOOR	114.3	100%
SECOND FLOOR	114.3	100%
TOTAL	228.6	100%

AS BUILT

All Enquiries to



REV	DATE	NOTE
PROJECT: BALLYBOUGHAL COMMERCIAL UNIT		
CLIENT: GLENWEAGH HOMES LTD.		
DRG TITLE: FIRST FLOOR PLAN		
DRAWN BY: DORAN CRAV		
SCALE @ A1: AS SHOWN		
DATE: JAN 2020		
DRAWN BY: E. DORAN		
NO	REV	DATE
1	1	10/01/20
2	1	10/01/20
3	1	10/01/20