Folio Number: KY9702

Application Number: P2014LR003051Y

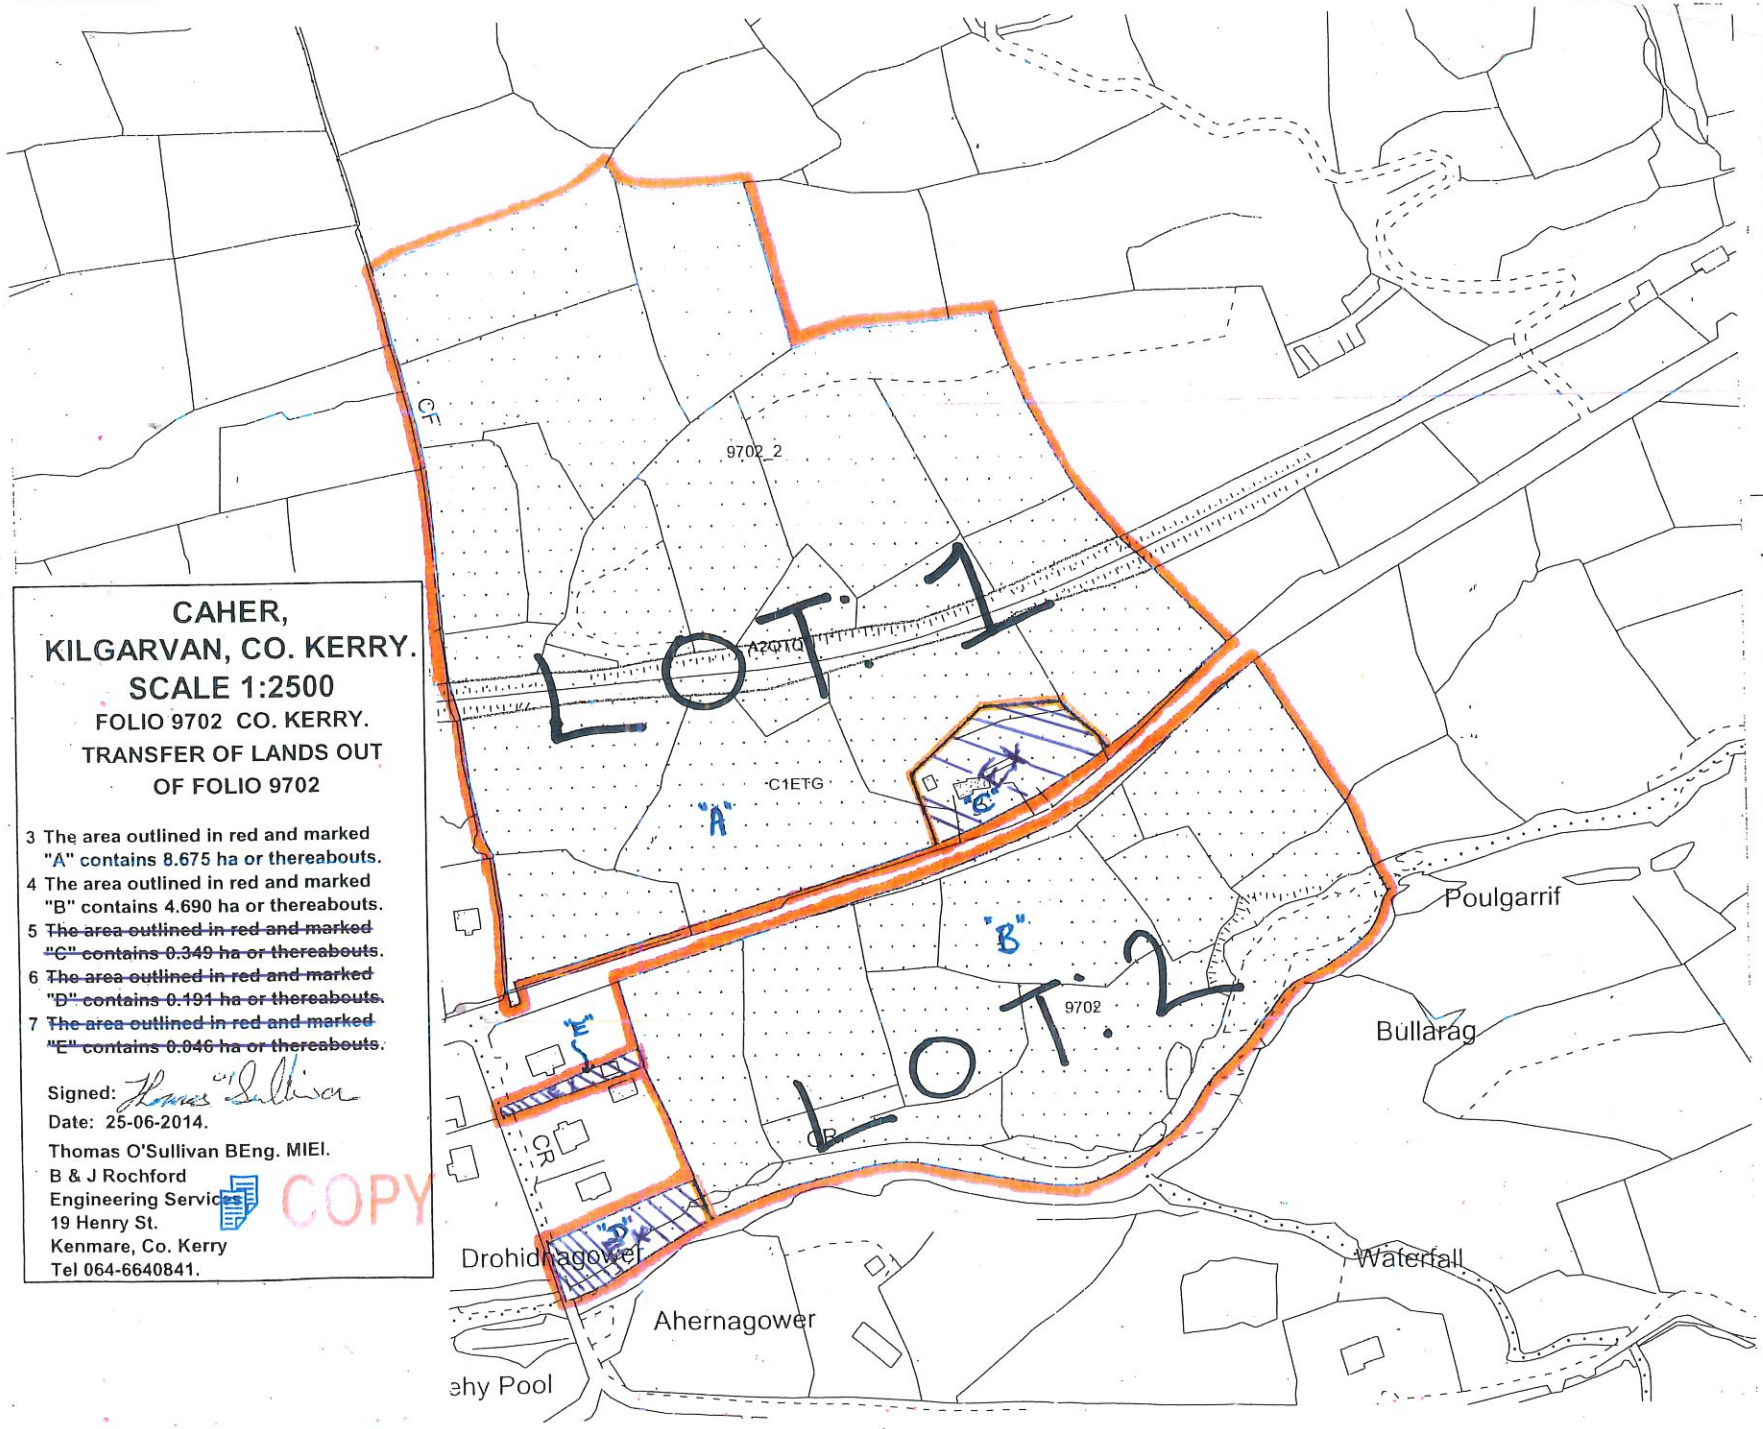

CAHER, KILGARVAN, CO. KERRY.
SCALE 1:2500
FOLIO 9702 CO. KERRY.
TRANSFER OF LANDS OUT OF FOLIO 9702

3 The area outlined in red and marked "A" contains 8.675 ha or thereabouts.
4 The area outlined in red and marked "B" contains 4.690 ha or thereabouts.
5 ~~The area outlined in red and marked "C" contains 0.349 ha or thereabouts.~~
6 ~~The area outlined in red and marked "D" contains 0.191 ha or thereabouts.~~
7 ~~The area outlined in red and marked "E" contains 0.046 ha or thereabouts.~~

Signed: Thomas O'Sullivan
Date: 25-06-2014.

Thomas O'Sullivan BEng. MIEI.
B & J Rochford
Engineering Services
19 Henry St.
Kenmare, Co. Kerry
Tel 064-6640841.

COPY

The Property Registration Authority
An tÚdarás Clárúcháin Maoine

Folio: KY9702

This map should be read in conjunction with the folio.

Registry maps are based on OSi topographic mapping. Where registry maps are printed at a scale that is larger than the OSi published scale, accuracy is limited to that of the orignial OSi map scale.

For details of the terms of use and limitations as to scale, accuracy and other conditions relating to Land Registry maps, see www.prai.ie.

This map incorporates Ordnance Survey Ireland (OSi) mapping data under a licence from OSi. Copyright © OSi and Government of Ireland.

(centre-line of parcel(s) edged)

- Freehold
- Leasehold
- SubLeasehold

Burdens (may not all be represented on map)

- Right of Way / Wayleave
- Turbary
- Pipeline
- Well
- Pump
- Septic Tank
- Soak Pit

A full list of burdens and their symbology can be found at: www.landdirect.ie

The registry operates a non-conclusive boundary system. The Registry Map identifies properties not boundaries meaning neither the description of land in a register nor its identification by reference to a registry map is conclusive as to the boundaries or extent. (see Section 85 of the Registration of Title Act, 1964). As inserted by Section 62 of the Registration of Deed and Title Act 2006.

1:2500 Scale