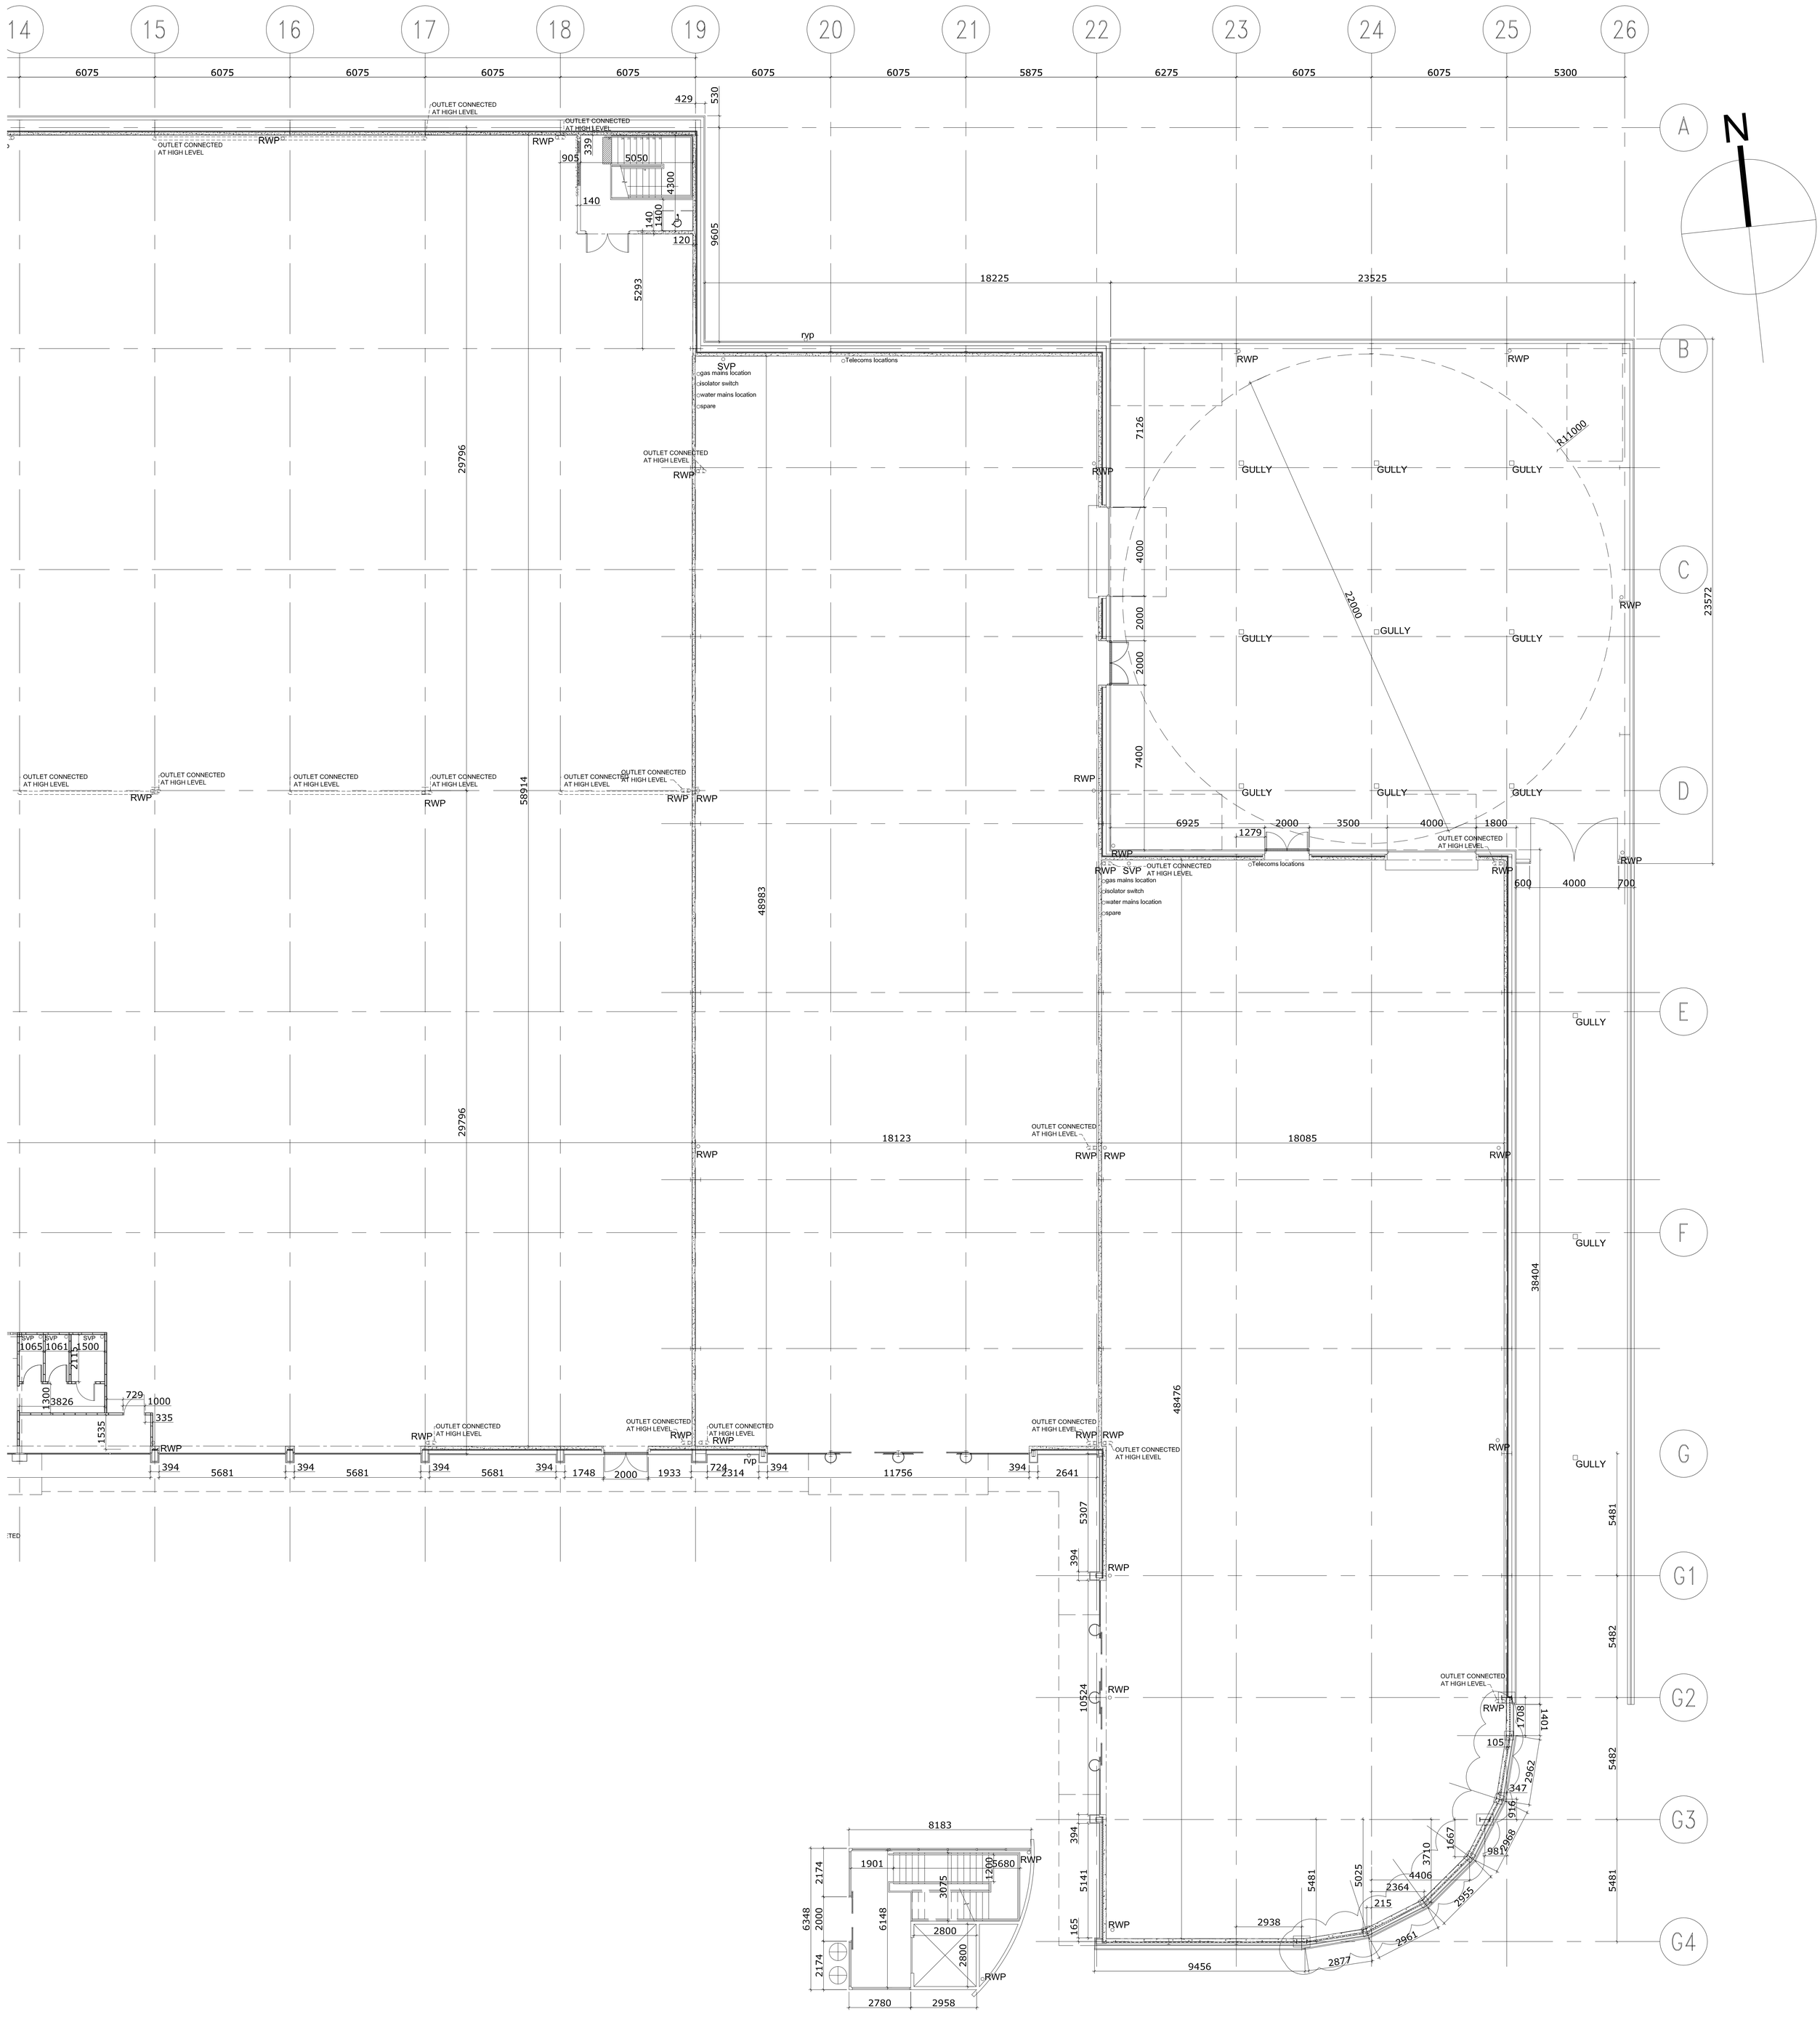

AS BUILT

CLIENT	GRAFTON GROUP PLC		
PROJECT	RETAIL CENTRE NAVAN		
DRAWING	UNITS 7 to 8 PLANS		
DATE	09-05-06		
SCALE	1:100	DRAWN B.H.	CHECKED X
DRG. NO.	3149-110	REVISION –	

JNP ARCHITECTS
THE JOHN NEIL PARTNERSHIP
ARCHITECTS . PLANNERS . PROJECT MANAGERS
133 ROYAL AVENUE, BELFAST BT1 1FG
TEL:+44 (0)28 90330111 FAX+44 (0)28 90244699
E: initial.surname@jnp-architects.com
9 SEVILLE PLACE, DUBLIN 1
TEL: +353 (0) 18558188 FAX: +353 (0)18558227
E: initial.surname@jnp-architects.net

DO NOT SCALE THIS DRAWING. ARCHITECTS / ENGINEERS TO BE NOTIFIED OF ANY DISCREPANCIES IN FIGURED DIMENSIONS. CONTRACTOR MUST CHECK ALL DIMENSIONS FROM SITE. THIS DRAWING IS COPYRIGHT AND FOR USE ON THIS SITE ONLY.